FORM 51 10M 8-47


KANSAS Greenwood

Section 22 Township 24 Range ~~12E~~

Well No. #13 Johnson

Company A Landon

Virgil Pool

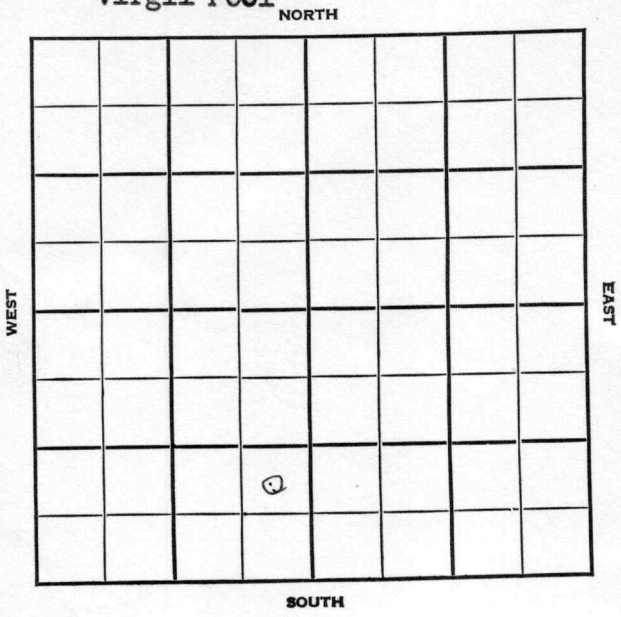

FORM 252-A
5M 12-45 PETROL

KANSAS Greenwood

Sec. 22 Twp. 24 R. 12E

Well No. #13 Johnson Farm

A. Landon Company

Virgil


____ Ft. from N. Line

990 Ft. from S. Line

330 Ft. from E. Line

____ Ft. from W. Line

NE SE SW

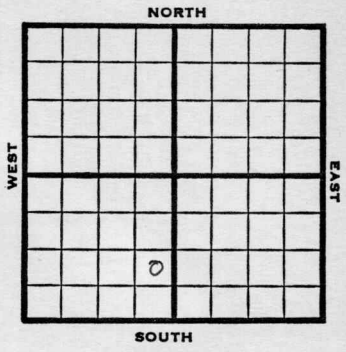

1948 Elev. 1703' REPORT

4/14 10" @ 610'
Drlg. 910'

5/12 "

5/19 "

5/26 Miss 1676'
6" @ 1355'
5½" @ 1676'
Pump 40 oil Pot.
Gr. 38
TD 1703

COMPLETED

Form 26—200 Bks.—1-48—Palace

Kansas

Virgil Pool

Map No._____ Sec. 22 Twp. 24 R. 12E


Well No. 13 Johnson

A. Landon Company

FIRST REPORT Contractor

NE SE SW

SECTION PLAT

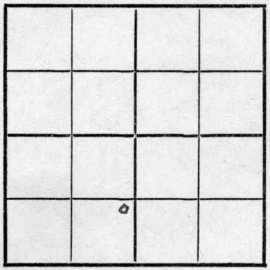

_____ Ft. from N. Line

990 Ft. from S. Line

330 Ft. from E. Line

_____ Ft. from W. Line

Greenwood County

Location_____

Rig up_____

Drilling and Remarks:

10" @ 610

drlg. 910

RECORD

Cased_____ in., _____ ft.

Sand_____

Gas_____

Oil_____

Total Depth_____

PRODUCTION

1st 24 hrs. Nat._____

1st 24 hrs. after shot_____

Gas_____ Cu. Ft.

Dry Hole_____

Abandoned_____

Date

APR 1 4 1948 19____ S. J. LEWIS Scout

Form 26—200 Bks.—1-48—Palace

Kansas

Virgil Pool

Map No. 16 Sec. 22 Twp. 24 R. 12E


Well No. 13 Johnson

A. Landon Company

COMPLETE Contractor

NE SE SW

SECTION PLAT

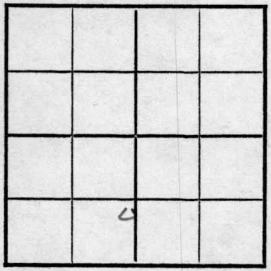

____ Ft. from N. Line

990 Ft. from S. Line

330 Ft. from E. Line

____ Ft. from W. Line

Greenwood County

Location

Rig up

Drilling and Remarks:

Kris 1676
6" C. 1955
5½ @ 1676.
Pump for oil Bd
85% Gr

RECORD

Cased ____ in., ____ ft.

Sand

Gas

Oil

Total Depth 1705

PRODUCTION

1st 24 hrs. Nat.

1st 24 hrs. after shot

Gas ____ Cu. Ft.

Dry Hole

Abandoned

Date

MAY 26 1948 19 S. J. LEWIS Scout