


KANSAS

Section 22 Township 24 Range 12-E

Well No. #18 Johnson

Company A M Landon

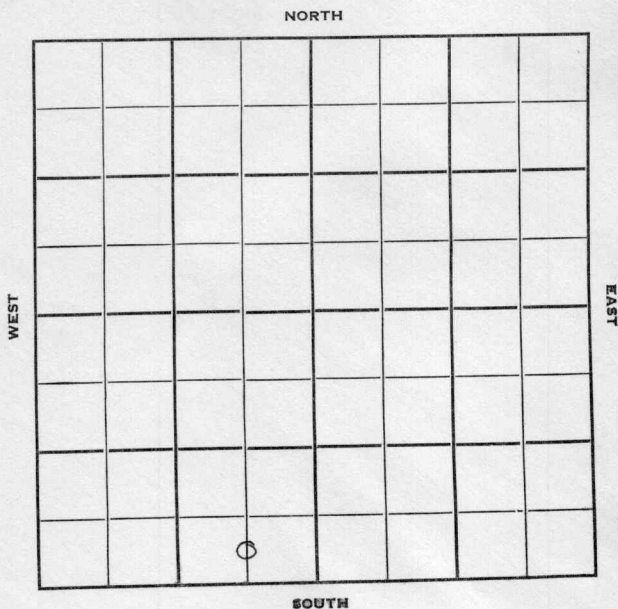

Greenwood

KANSAS

Sec. 22 Twp. 24 R. 12E 1

Well No. #18 Johnson Farm

A. M. Landon Company

Virgil Pool

Contractor


 Ft. from N. Line

330' Ft. from S. Line

660' Ft. from E. Line

 Ft. from W. Line

C S L SE SW

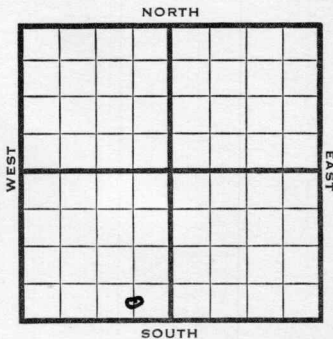

1950

REPORT

8/23

Spud 8-6-50
10" @ 30'
Drlg. 1550'

9/13

Spud 8-6-50
Oil Well TD 1713
10" @ 30'
Miss 1690'
TD 1713'
4" @ 1690'
200 A Comp. 5 BOPD

COMPLETED

County Greenwood State KansasSec. 22 (Blk. Twp.) 24 (Sur. Rge.) 12E Map No.Operator A. M. LandonWell No. 18 Farm JohnsonElev. _____ Location C S L SE SW


330 Ft. From S Line SW660 Ft. From E Line Quarter1st. Report AUG 23 1950

Completion _____

Remarks _____

Spudding Date 8-6-50Drlg. Data Virgil Pool10" @ 30 drlg. 1550

J. E. TYRA

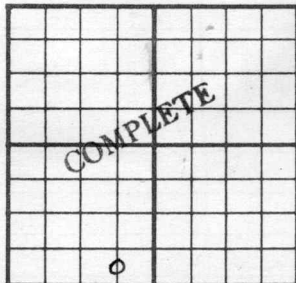County Greenwood State KansasSec. 22 (Blk.
Twp.) 24 (Sur.
Rge.) 12E Map No.Operator A. M. LandonWell No. 18 Farm JohnsonElev. Location C S L SE SW330 Ft. From S Line SW660 Ft. From E Line Quarter

1st. Report

Completion SEP 13 1950

Remarks

Virgil PoolSpudding Date 8-6-50Drlg. Data Oil well TD 171310" @ 30 Miss. 1690 TD 1713 4" @ 1690200 A Comp. 5 bopd

J. E. TYRA