


Section.....22.....Township.....24.....Range.....12-E

Well Number.....7 - Texas Johnson.....

Company.....A. M. Landon.....

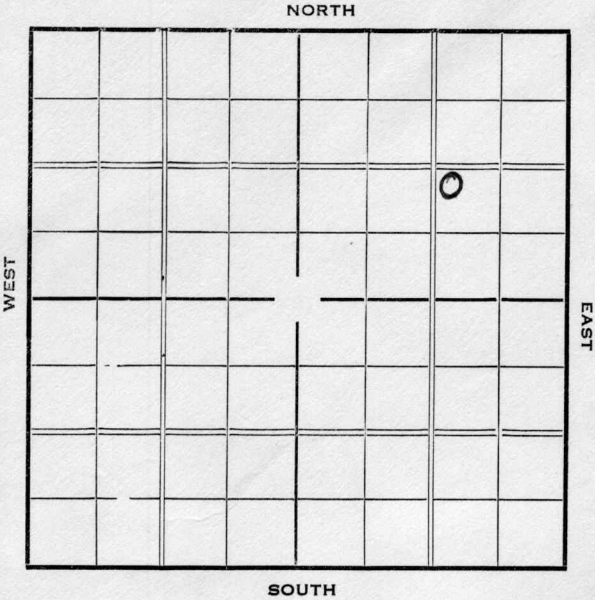

KANSAS

Greenwood

Map No. 16 Sec. 22 Twp. 24 R. 12EWell No. 7 - Texas JohnsonA. M. Landon Company

Contractor

FIRST REPORT

SECTION PLAT

			0

_____ Ft. from N. Line

1240 Ft. from S. Line1235 Ft. from E. Line

_____ Ft. from W. Line

Location _____

Rig up _____

Drilling and Remarks:

Rign up mach

This was formerly a
Texas Co. Lse but
AIF Landon has Taken
it over

RECORD

Cased _____ in., _____ ft.

Sand _____

Gas _____

Oil _____

Total Depth _____

PRODUCTION

1st 24 hrs. Nat. _____

1st 24 hrs. after shot _____

Gas _____ Cu. Ft.

Dry Hole _____

Abandoned _____

Date

JUN 23 1937 19E. D. Hatfield Scout

Map No. 16^N Sec. 22 Twp. 24 R. 12 ^E

Well No. 7-Texas Johnson

A. M. Landon Company

Contractor

COMPLETED

SECTION PLAT

			0

 Ft. from N. Line

1240 Ft. from S. Line

1235 Ft. from E. Line

 Ft. from W. Line

Location

Rig up

Drilling and Remarks:

Shot 60 gts

Est. 25 bbls

RECORD

Cased 6 in., 1585 ft.

Sand Bart 1611

Gas (Corrected)

Oil

Total Depth 1640

PRODUCTION

1st 24 hrs. Nat.

1st 24 hrs. after shot

Gas Cu. Ft.

Dry Hole

Abandoned

Date

AUG 11 1937

19

H. D. Hatfield

Scout