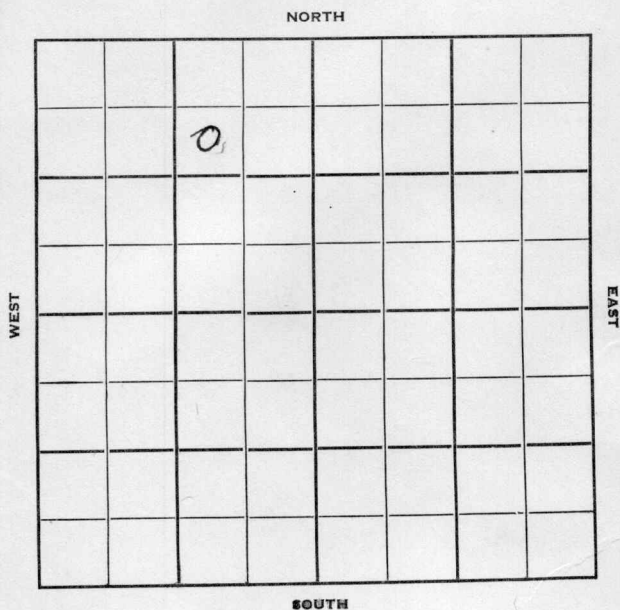


Section 22 Township 24 Range 12EWell No. #5 R. Johnson "B"Company Alf Landon

Sec. 22 Twp. 24 R. 12 E ✓

Well No. # 5 R. Johnson "B" Farm

Alf Landon Company

Virgil Pool Contractor


990 Ft. from N. Line

Ft. from S. Line

990 Ft. from E. Line

Ft. from W. Line

SW NE NW

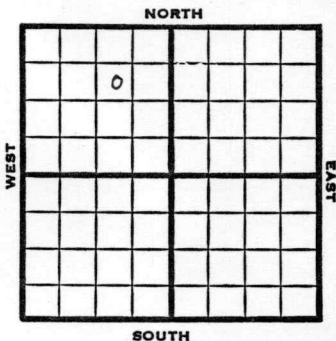

1951

Elev. - REPORT

10/3

Spud 9-27-51
Drlg. 680'

10/31

Spud 9-27-51
D&A TD 1733
10" @ 695
KC 890
Miss 1695
TD 1733
D&A

ABANDONED

County	Greenwood				State	Kansas
Sec.	22	(Blk.) (Twp.)	24	(Sur.) (Rge.)	12E	Map No.

Sec. **22** (Blk. Twp.) **24** (Sur. Rge.) **12E** Map No.

Operator **Alf Landon**

Well - No. 5 Farm R. Johnson "B"

Elev.	Location	SW	NE	NW
-------	----------	----	----	----

990 Ft. From **N** Line **NW**

990 Ft. From E Line Quarter

1st. Report OCT 3 1951

Completion

Remarks

Spudding Date 9-27-51


Virgil Pool

Drlg. Data

drlg. 680

J. E. TYRA

County Greenwood State Kansas
Sec. 22 (Blk.) 2 4 (Sur.) 12E Map No.
Operator Alf Landon
Well No. 5 Farm R. Johnson "B"
Elev. Location SW NE NW

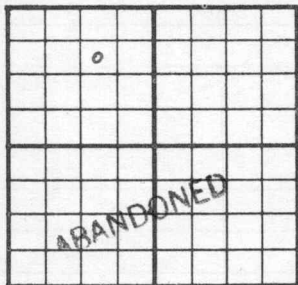

990 Ft. From N Line NW
990 Ft. From E Line Quarter
1st. Report
Completion OCT 31 1951
Remarks Virgil Pool
Spudding Date 9-27-51

Drlg. Data D & A TD 1733
10" @ 695 KC 890 Miss. 1695
TD 1733 D & A

J. E. TYRA