


Section 4 Township 20 Range 16 WWell No. # 1 Hagerman "A"Company Ben Brack Oil

NORTH

WEST

EAST

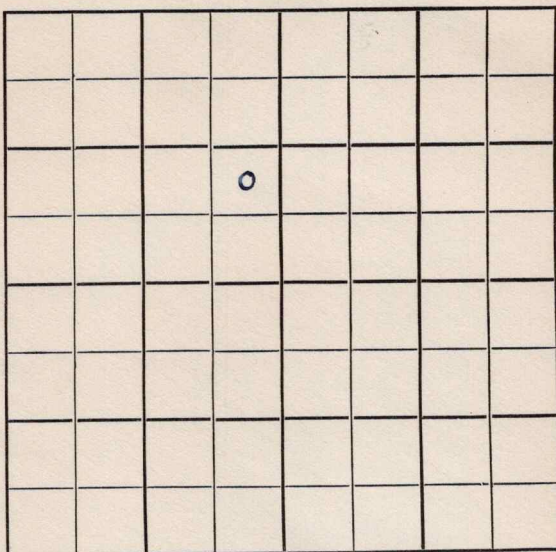

SOUTH

Pawnee

KANSAS

Sec. 14 Twp. 20 R. 16 W

Well No. # 1 Hagerman "A" Farm

Ben Brack Oil Company

Brack Contractor


 Ft. from N. Line

990 Ft. from S. Line

330 Ft. from E. Line

 Ft. from W. Line

NE SE NW

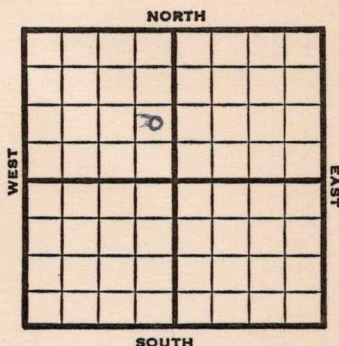

1951

Elev. 2009' REPORT


3/7

Spud 3-4-51
Drilling 738'

5/9

Spud 3-4-51
Oil Well TD 3737
8" @ 739
Anhy 1055' Br Lime 3401
KC 3412 Arb. 3696
TD 3736 5" @ 3736
F/11 bo 1 hr F/38 bo 5 hr
DD 3737 F/6 boph Comp. 96 bopd

COMPLETED

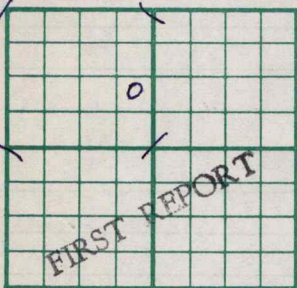County Pawnee State KansasSec. 4 (Blk.) 20 (Sur.) 16W Map No.Operator Ben Brack OilWell No. 1 Farm Hagerman "A"Elev. Location NE SE NW990 Ft. From S Line NW330 Ft. From E Line Quarter1st. Report MAR 7 1951

Completion


Remarks

Brack - Contr.Spudding Date 3-4-51

Drlg. Data

drlg. 738

J. E. TYRA

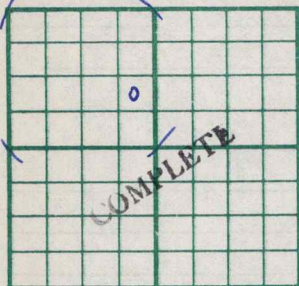County Pawnee State KansasSec. 4 (Blk.
Twp.) 20 (Sur.
Rge.) 16W Map No.Operator Ben Brack OilWell No. 1 Farm Hagerman "A"Elev. 2009 Location NE SE NW990 Ft. From S Line NW330 Ft. From E Line Quarter1st. ReportCompletion MAY 9 1951RemarksBrack - Contr.Spudding Date 3-4-51Drlg. Data Oil well TD 37378" @ 739 Anhy 1055 Br. lime 3401KC 3412 Arb. 3696 TD 3736 5" @ 3736F/ 11 bo 1 hr. F/ 38 bo 5 hr. DD 3737F/ 6 boph 44 Comp. 96 bopd

J. E. TYRA