


Section 1 Township 20 Range 16W

Well No. 1 Erickson

Company Magnolia

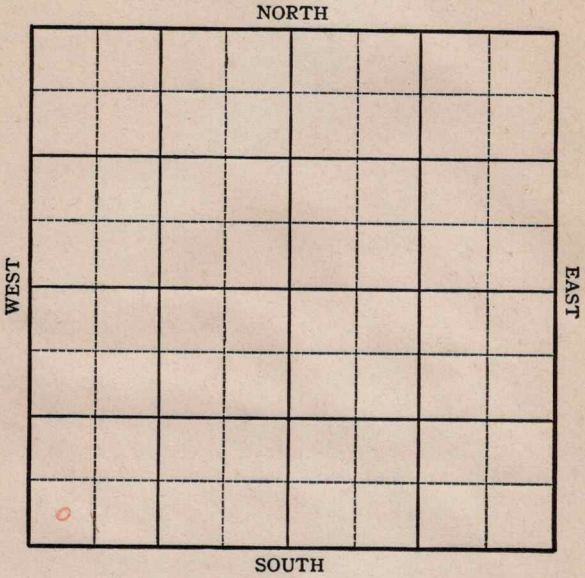

Sec. 1 Twp. 20 R. 16-W

Well No. #1 Brickson Farm
Magnolia Company


 Ft. from N. Line

330 Ft. from S. Line

 Ft. from E. Line

330 Ft. from W. Line

SW/c

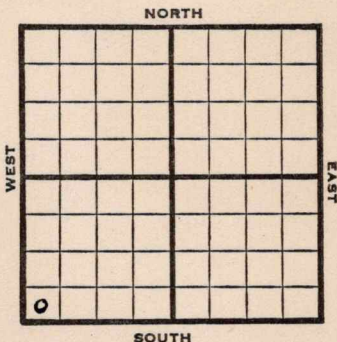

1945 **Elev. 2002** REPORT

- 11/14 RUR
- 11/21 **Anhy. 1015**
8" @ 1020
Drlg. 3000'
- 11/28 Drlgl 3340
- 12/5 **Lans 3396**
Arb. 3684
TD 3731
5" @ 3730 RUST
- 12/12 TD 3737
SO 1000 acid.
- 12/20 T.D. 3739' 1500 acid. Flow 51 oil
in 18 hours.
- 12/28 **Arb. 3684**
5" @ 3730
2500 acid.
TD 3737'
Flow 70 Pot.
Grav. 39.0

COMPLETED

