

KANSAS


Pawnee County

FORM 51 5M PETROL

Section 3 Township 20 Range 16W

Well No. 2 Fleske

Company Magnolia

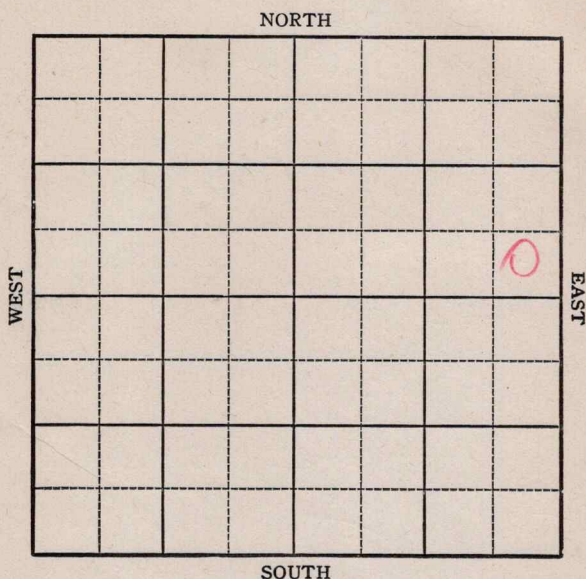

KANSAS

Pawnee

Sec. 3 Twp. 20 R. 16W

Well No. 2 Fleske Farm

Magnolia Company

Ryan

Ft. from N. Line

330


Ft. from S. Line

330

Ft. from E. Line

Ft. from W. Line

SE NE

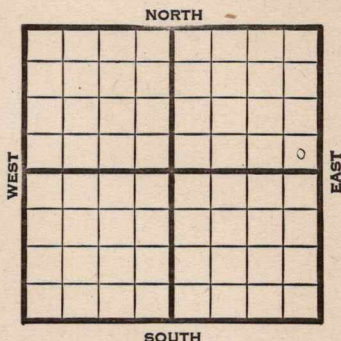

1945

Elev. 1988

REPORT

6/6
6/14
6/21
6/28

7/3
7/11
7/19
7/25

Location

8" @ 125 WOC

Drlg. 2750

Lams 3391

Arb 3670

TD 3720

5" @ 3719 RUST

TD 3727

$\frac{1}{4}$ oil per hr. 6 hrs.

3732 Flow 3 oil per hr 12 hrs.

24 shots 3714-3719 testing

Arb. 3670

5" @ 3719

Perf. Arb. 500 cid.

TD 3727

Flow 74 Pot.

Grav. 39.0

COMPLETED

Kansas Pool Name RyanMap No. 81 Sec. 3 Twp. 20 R. 16WWell No. 2 FleskeMagnolia

Company

FIRST REPORT

Contractor

SE NE

SECTION PLAT

Ft. from N. Line

330 Ft. from S. Line330 Ft. from E. Line

Ft. from W. Line

Pawnee County

Location X

Rig up

Drilling and Remarks:

RECORD

Cased _____ in., _____ ft.

Sand _____

Gas _____

Oil _____

Total Depth _____

PRODUCTION

1st 24 hrs. Nat. _____

1st 24 hrs. after shot _____

Gas _____ Cu. Ft.

Dry Hole _____

Abandoned _____

Date

JUN 6 1945

19

S. J. LEWIS

Scout

KANSAS


Kansas Pool Name RyanMap No. 81 Sec. 3 Twp. 20 R. 16WWell No. 2 FleskeMagnolia

Company

COMPLETED

Contractor

SE NE

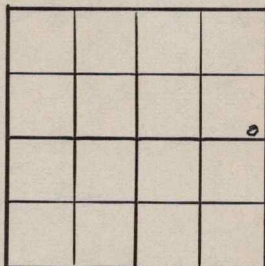E 1, 1988
SECTION PLAT Ft. from N. Line330 Ft. from S. Line330 Ft. from E. Line Ft. from W. Line

Pawnee County

Location Rig up

Drilling and Remarks:

Per 836705' 03719Per 83670Flow 74 BT39 2/3**RECORD**Cased in., ft.Sand Gas Oil Total Depth 8727**PRODUCTION**1st 24 hrs. Nat. 1st 24 hrs. after shot Gas Cu. Ft.Dry Hole Abandoned

Date

JUL 25 1945

19

S. J. LEWIS Scout