
KANSAS
FORM 51 5M 6-46 PETROL

Pawnee County

Section 8 Township 20 Range 16-W

Well No. #1 Rutheford "A"

Company Magnolia

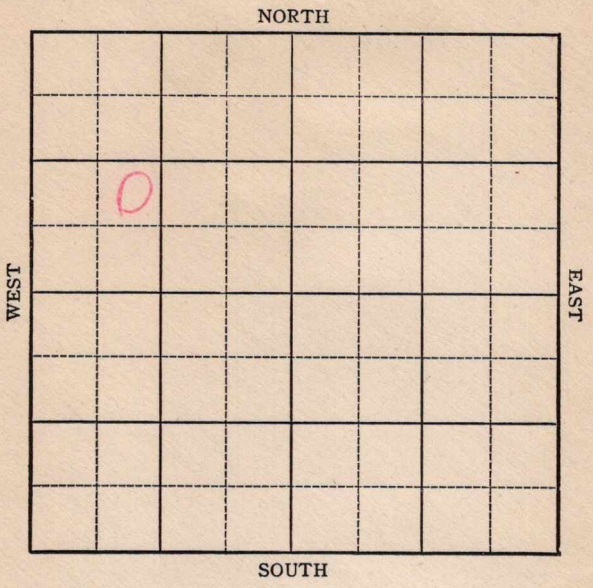

FORM 252-A
5M 6-46 PETROL

KANSAS Pawnee County

Sec. 8 Twp. 20 R. 16W

Well No. #1 Rutheford "A" Farm

Magnolia Company

No


_____ Ft. from N. Line

990 Ft. from S. Line

_____ Ft. from E. Line

990 Ft. from W. Line

NE SW NW

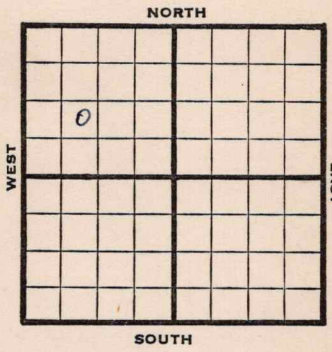

1946	2110 Elev. REPORT
7/31	325'
8/6	8" @ 1166 Drlg 2464'
8/15	Lansing 3507' Arb. 3875' T.D. 3879' D&A (Tel)
8/14	Lans 3507 Arb. 3875 TD 3879'

ABANDONED

FORM 56 200 BKS. 1-44 PETROL

KANSAS Kansas Pool Name No

Map No. Sec. 8 Twp. 20 R. 16W


Well No. 1 Rutheford "A"

Magnolia Company

FIRST REPORT Contractor

NE SW NW

SECTION PLAT

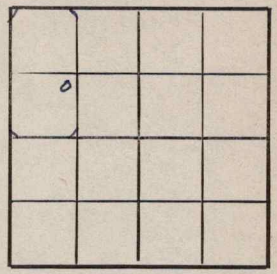

Ft. from N. Line

990 Ft. from S. Line

Ft. from E. Line

990 Ft. from W. Line

Pawnee County

Location

Rig up

Drilling and Remarks:

325'

RECORD

Cased in., ft.

Sand

Gas

Oil

Total Depth

PRODUCTION

1st 24 hrs. Nat.

1st 24 hrs. after shot

Gas Cu. Ft.

Dry Hole

Abandoned

Date

JUL 3 1 1946 19 S. J. LEWIS Scout

FORM 26 200 BKS. 2-44 PETROL

KANSAS Kansas Pool Name No name

Map No. 81 Sec. 8 Twp. 20 R. 16W

Well No. 1 Rutherford "A"


Magnolia Company

ABANDONED Contractor

NE SW NW

E1, 2110

SECTION PLAT

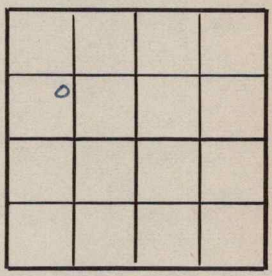

Ft. from N. Line

990 Ft. from S. Line

Ft. from E. Line

990 Ft. from W. Line

Pawnee County

Location

Rig up

Drilling and Remarks:

Lans 3509
Arb 3875

RECORD

Cased in., ft.

Sand

Gas

Oil

Total Depth 3879

PRODUCTION

1st 24 hrs. Nat.

1st 24 hrs. after shot

Gas Cu. Ft.

Dry Hole

Abandoned

Date

AUG 14 1946 19 S. J. LEWIS Scout