FORM 51 IOM 12-46 PETROL


KANSAS

Pawnee county

Section 8 Township 20 Range 16-W

Well No. #1, Rutherford "B"

Company Magnolia Petroleum Company

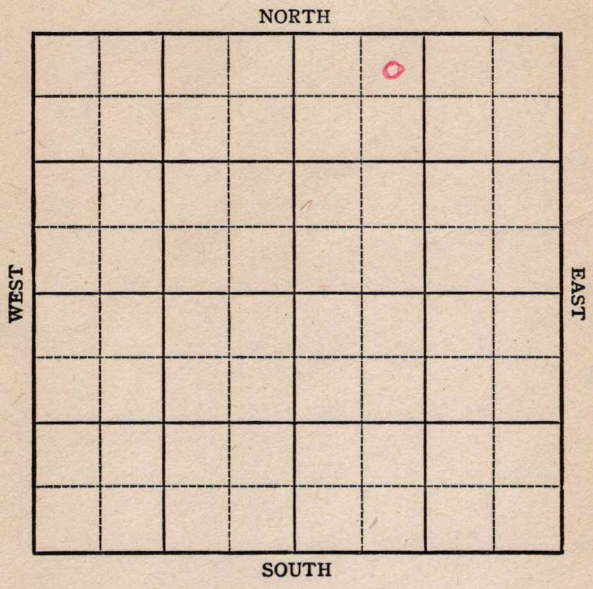

FORM 252-A
5M 6-46 PETROL

KANSAS

Pawnee

Sec. 8 Twp. 20 R. 16W

Well No. 1 Rutherford "B" Farm

Magnolia Company

Rutherford


330 Ft. from N. Line

Ft. from S. Line

Ft. from E. Line

990 Ft. from W. Line

NE NW NE

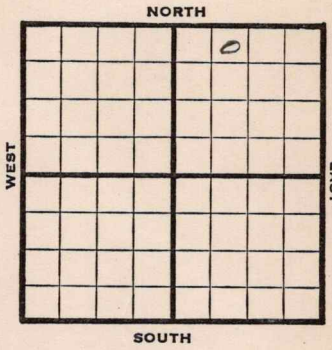

1946	REPORT
	Elev. 2046
11/27	Location
12/3	Drlg 750'
12/10	Anhy 1096' 8" @ 1100' Drlg 2540'
12/17	3584 fsg
1947	
1/4	Set Whipstock @ 1518' WOC
1/8	Skid Ri 50' North RUR
1/15	8" @ 1102 Drlg 1771'
1/21	D Drlg 3380'
1/29	TD 3854' Lans 3457 Simp 3808 Arb 3833

ABANDONED

Form 26 200 Bks. 10-46 Petrol

Kansas

Rutherford

Map No. 8 Sec. 8 Twp. 20 R. 16W

Well No. 1 Rutherford "B"

Magnolia Company

FIRST REPORT Contractor

NE NW NE


330 Ft. from N. Line

Ft. from S. Line

Ft. from E. Line

990 Ft. from W. Line

SECTION PLAT

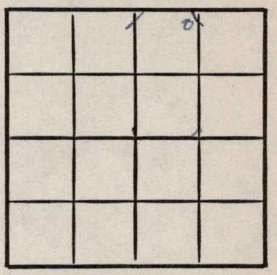

Pawnee County

Location x

Rig up

Drilling and Remarks:

RECORD

Cased in., ft.

Sand

Gas

Oil

Total Depth

PRODUCTION

1st 24 hrs. Nat.

1st 24 hrs. after shot

Gas Cu. Ft.

Dry Hole

Abandoned

Date

NOV 2 7 1946 19 S. J. LEWIS Scout

Form 26 200 Bks. 10-46 Petrol

Kansas

Rutherford Pool

Map No. 81 Sec. 8 Twp. 20 R. 16W

Well No. 1 Rutherford "B"


Magnolia Company

ABANDONED Contractor

NE NW NE

E 12046

SECTION PLAT

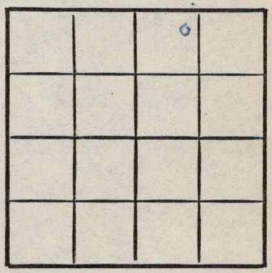

330 Ft. from N. Line

Ft. from S. Line

Ft. from E. Line

990 Ft. from W. Line

Pawnee County

Location

Rig up

Drilling and Remarks:

Lans 3457
Simp 3805
Ark 3833

RECORD

Cased in., ft.

Sand

Gas

Oil

Total Depth 3845

PRODUCTION

1st 24 hrs. Nat.

1st 24 hrs. after shot

Gas Cu. Ft.

Dry Hole

Abandoned

Date

JAN 29 1947 19

S. J. LEWIS Scout