


Section 11 Township 20 Range 16W

Well No. 2 Knoche

Company Magnolia

Ryan Pool

NORTH

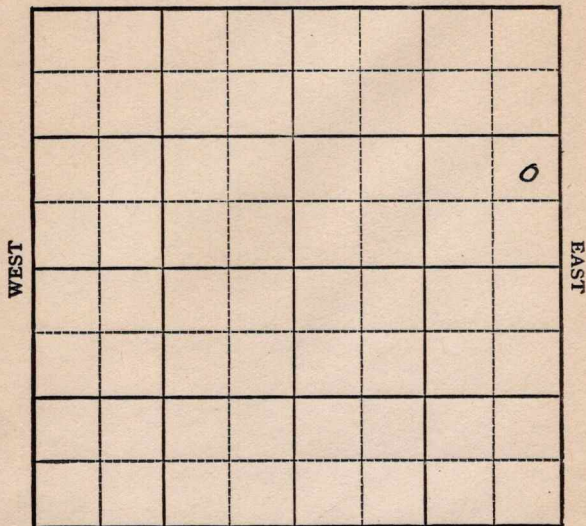

SOUTH

MINNAPAS

Pawnee ✓

Sec. 11 Twp. 20 R. 16W

Well No. 2 Knoche Farm

Magnolia Company


Ryan Pool

_____ Ft. from N. Line

990 Ft. from S. Line

330 Ft. from E. Line

_____ Ft. from W. Line

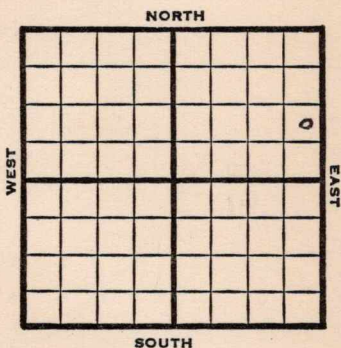

NE SE NE

1948 **Lev 2014'** REPORT

11/17 Location
11/23 "
11/30 RUR
12/6 10" @ 1040'
12/15 "
12/22 **Lansing 3417'**
Arbuckle 3695'
TD 3746'
6" @ 3744'
12/29 Swb 3/4" bbls fluid
PH 12 hrs. 90% W PB 3744

1/5 "

1/12 TD 3754 1400' w 7 hrs.
1/19 "
1/26 "
2/2 PB 3734'
90 shots 3702-22
2000 acid swb 2 bbls oil & 1/2 WPH
6 hrs.

2/9 SD

2/16 "
2/23 TD 3754'
Arb. 3695'
6" @ 3744'
Aband.

ABANDONED

Map No. _____ Sec. 11 Twp. 20 R. 16W

Well No. 2 Knoche

Magnolia Company

FIRST REPORT Contractor

NE SE NE

SECTION PLAT

_____ Ft. from N. Line

990 Ft. from S. Line

330 Ft. from E. Line

_____ Ft. from W. Line

			o

Pawnee County

Location X

Rig up _____

Drilling and Remarks:

RECORD

Cased _____ in., _____ ft.

Sand _____

Gas _____

Oil _____

Total Depth _____

PRODUCTION

1st 24 hrs. Nat. _____

1st 24 hrs. after shot _____

Gas _____ Cu. Ft.

Dry Hole _____

Abandoned _____

Date

NOV 17 1948

19

S. J. LEWIS

Scout

