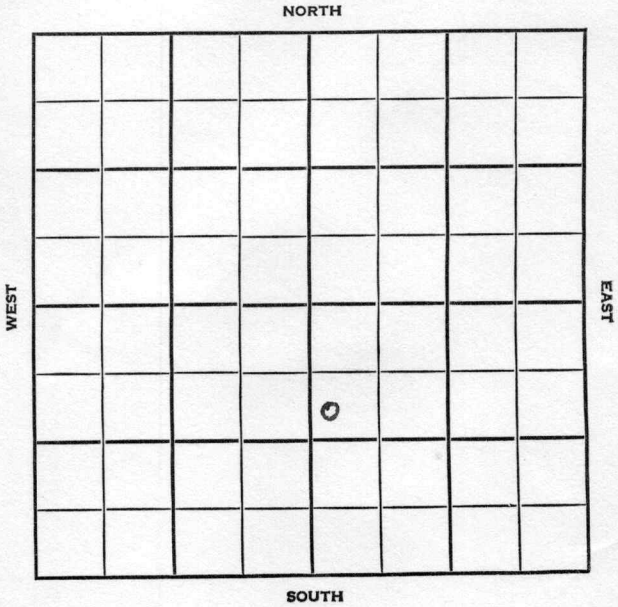


Section 23 Township 24 Range 12EWell No. 38 JohnsonCompany Hart Bros.

Greenwood KANSAS

SEC.	TWP.	R.
23	24	12E

WELL NO.

38 Johnson FARM

COMPANY

Hart Bros.

CONTRACTOR

Sauder


Virgil Pool

1000 _____ Ft. from N. Line

_____ Ft. from S. Line

_____ Ft. from E. Line

200 _____ Ft. from W. Line

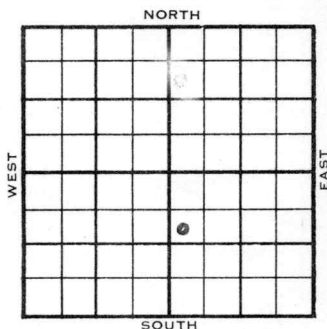

SW NW SE

	ELEVATION	REPORT
1955	-	

1/26 Spud 1-19-55
10" @ 464'
Drlg. 825'

2/16 Spud 1-19-55 - Oil Well
TD 1685'
10" @ 464'
Bart. 1590', Miss. 1658'
TD 1685'
7" @ 1675'
CO to 1685'
Sd-oil-frac
Comp. 10 bopd

COMPLETED

County **Greenwood** State **Kansas**

Sec. **23** (Blk.) **24** (Sur.) **12E** Map No.

Operator **Hart Bros.**

Well No. **38** Farm **Johnson**

Elev.	Location	SW	NW	SE
-------	----------	----	----	----


1000 Ft. From N Line SE

200 Ft. From W Line Quarter

1st. Report JAN 26 1955

Completion

Remarks

Sauder - Contr.


Spudding Date **1-19-55**

Drlg. Data **Virgil Pool**

10" @ 464 drlg. 825

FABEN GILSTRAP

County Greenwood State Kansas
 Sec. 23 (Blk.) 24 (Sur.) 12E Map No.
 Operator Hart Bros.
 Well No. 38 Farm Johnson
 Elev. Location SW NW SE

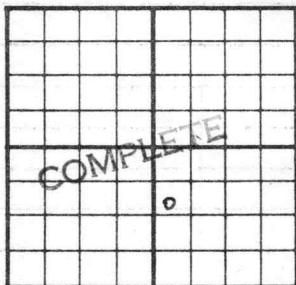

1000 Ft. From N Line SE
200 Ft. From W Line Quarter
 Ist. Report
 Completion FEB 1 6 1935
 Remarks Virgil Pool
Sauder - Contr.
 Spudding Date 1-19-55

Drlg. Data Oil well TD 1685
10" @ 464 Bart. 1590 Miss. 1658
TD 1685 7" @ 1675 C0 to 1685
sd-oil-frac Comp. 10 bopd

FABEN GILSTRAP