


Map No. _____ Sec. 23 Twp. 24 R. 12
 Well No. 27 Johnson Farm
Foster Oil Co. Company

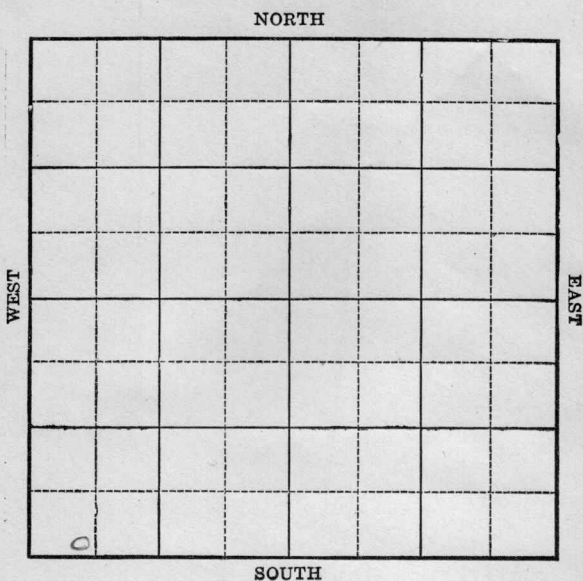

Location _____

Drilling Remarks:

Rig up _____

Drilling Remarks:

RECORD

Cased _____ in. _____ ft.

Sand _____

Gas _____

Oil _____

Total Depth _____

PRODUCTION

1st 24 hrs Nat. _____

1st 24 hrs. after shot _____

Gas _____ cu. ft.

Dry Hole _____


Abandoned _____

Map No. _____ Sec. 23 Twp. 24 R. 12Well No. 27 Johnson Farm
Foster Oil Company

_____ Ft. from N. Line

200 Ft. from S. Line

_____ Ft. from E. Line

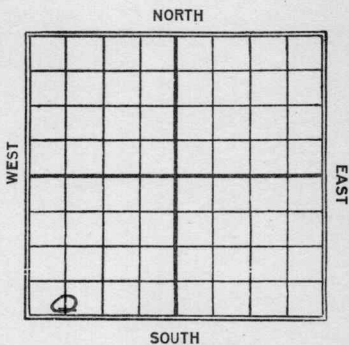660 Ft. from W. Line

Date

REPORT

19234/206/23

Dr. 500'
Jopline 1760- Pay 1761-
76-5 Bbs. Nat. J

SAS 16 Sec. 23 Twp. 24 R. 12
 No. 27 Johnson
 Foster Oil

Company

Contractor

FIRST REPORT

SECTION PLAT

Ft. from N. Line

200 Ft. from S. Line

Ft. from E. Line

660 Ft. from W. Line

Location

Rig up

Drilling and Remarks:

204500'

RECORD

Cased _____ in., _____ ft.

Sand _____

Gas _____

Oil _____

Total Depth _____

PRODUCTION

1st 24 hrs. Nat. _____

1st 24 hrs. after shot _____

Gas _____ Cu. Ft.

Dry Hole _____

Abandoned _____

Date

APR 20 1923

M. A. BENEAR

192

Scout

Map No. **KANSAS** 16 Sec. 23 Twp. 24 R. 12

Well No. 27 Johnson

Foster Oil Company

Contractor

COMPLETED**SECTION PLAT**

Ft. from N. Line

200 Ft. from S. Line

Ft. from E. Line

660 Ft. from W. Line

COMPLETED

Location

Rig up

Drilling and Remarks:

Tap Line 1760
 Pay { 1761
 1776

3 1/2 hrs not

RECORD

Cased _____ in., _____ ft.

Sand _____

Gas _____

Oil _____

Total Depth _____

PRODUCTION

1st 24 hrs. Nat. _____

1st 24 hrs. after shot _____

Gas _____ Cu. Ft.

Dry Hole _____

Abandoned _____

Date

JUN 23 1923

M. A. BENEAR

192

Scout