

DRILLING WELL COMPLETION REPORT

27-21-16^w

Well No. 1 Farm Name J. B. Cossman

Date Completed February 23, 1953

Description N $\frac{1}{2}$ SW $\frac{1}{4}$ Less that part North of West of AT&T Ry.

County Pawnee State Kansas

Initial Production 250 pump bbls. Total depth 3866 Feet

Initial Volume _____ cu. ft. _____ lbs rock pressure

M.C.P.C. Interest 100%

Remarks: Daily allowed - - 68 bbls.

A. E. Pierce

W


Mr. McDowell
Accounting Dept. 3
Scouting Dept.
Geological Dept.
Pipe Line Dept.
Materials Dept.
Rental Dept.
Legal Dept.
Mr. Leo Meyer
Engineering Dept.
Lease Inventory
Income Tax Dept.
File

LOCATION NOTICE

TULSA, OKLA., Jan. 16, 1953, 19.....

WELL NO. 1 ON J. B. Cossman FARM

WILL BE AS FOLLOWS:

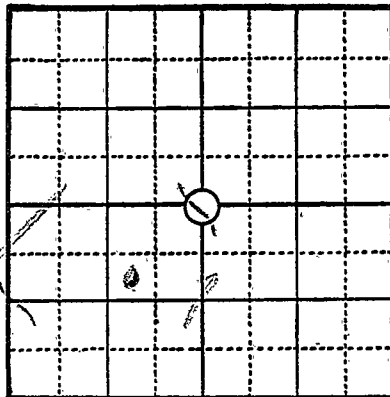

290 FEET FROM NORTH LINE

990 FEET FROM EAST LINE

FEET FROM SOUTH LINE

FEET FROM WEST LINE

75 Acres, N/2 SW 1/4 less that part North & West
of ATSF Ry.

IN SEC. 27 TWP. 21S RANGE 16W

Pawnee COUNTY, STATE OF Kansas

REMARKS: R. L. Mankey; R. O. Bobey

H. C. P. G. 100%

SIGNED A. E. Pierce

COPIES TO

R. W. McDOWELL
DISTRICT SUPT.
ACCOUNTING DEPT.
✓ SCOUTING DEPT.
GEOLOGICAL DEPT.
PIPE LINE DEPT.
MATERIALS DEPT.
RENTAL DEPT.
LEGAL DEPT.
LEO MEYER
INCOME TAX DEPT.
ENGINEERING DEPT.
LEASE INVENTORY
CLAIM DEPT.
J. W. BASORE
FILE

Card Typed - mm