

KANSAS

Pawnee


FORM 51 5M 10-41 PETROL

Section 12 Township 20 Range 16-W

Well No. #1 Clemson

Company Stanolind & Elbar

NORTH Pawnee Rock Pool

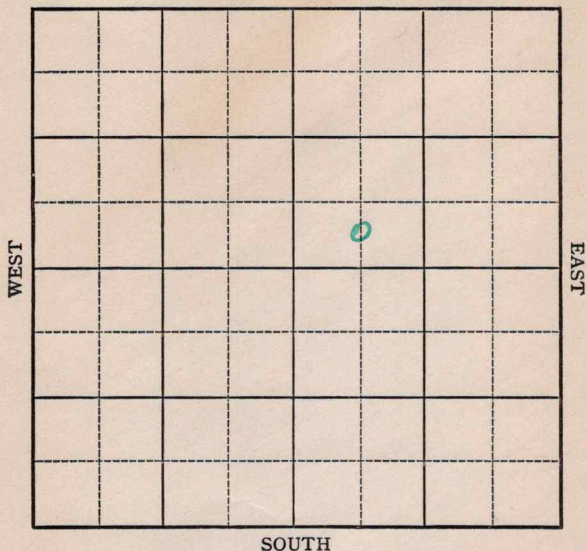

Sec. 12 Twp. 20 R. 16-W

Well No. #1 Clemson Farm

Stanolind & Elbar Company

(Pawnee Rock)


 Ft. from N. Line

330 Ft. from S. Line

 Ft. from E. Line

660 Ft. from W. Line

Elev. 2051

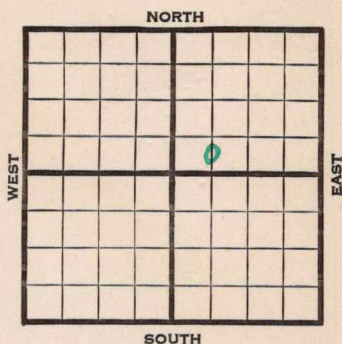

1942	REPORT
4/29	Location
5/6	"
5/13	Rotary.
5/20	10" - 631' Drlg. 1384'
5/27	Drlg. 3140'
6/3	Lans. 3485' Arb. 3738'
	T.D. 3804' SSO & G.
6/14	7" - 3803' RUST.
6/17	12 shots 3790-3794' 3000 acid.
	Squeeze off.
6/24	P.B. to 3783 $\frac{1}{2}$ ' 48 shots 3775-82'
	1000 acid. 3 M gas.
7/1	" " "
7/8	" " "
7/15	" " "
7/22	Shut down.
7/29	"
8/5	PB 3770 - 83 shots 3746-60
	1000 acid 2.7 M Gas SSO
8/12	" " " "
8/19	" " " "

OVER

751891

1942

8/27

Arb. 3738

7" - 3803

water

T.D. 3804

ABANDONED

Pawnee

KANSAS

Map No. 21 Sec. 12 Twp. 20 R. 16WWell No. 1 ClemsonStanolind & Elbar Company**FIRST REPORT**

Contractor

C S L S W N E

SECTION PLAT

		o	

 Ft. from N. Line330 Ft. from S. Line Ft. from E. Line660 Ft. from W. Line

PAWNEE ROCK POOL

Location XXRig up

Drilling and Remarks:

RECORD

Cased in., ft.Sand Gas Oil Total Depth

PRODUCTION

1st 24 hrs. Nat. 1st 24 hrs. after shot Gas Cu. Ft.Dry Hole Abandoned

Date

APR 29 1942 19S. J. LEWIS Scout

Pawnee

KANSAS

Map No. 81 Sec. 12 Twp. 20 R. 16WWell No. 1 ClemsonStanolind & Elbar CompanyABANDONED Contractor

C SL SW NE

SECTION PLAT

 Ft. from N. Line330 Ft. from S. Line Ft. from E. Line660 Ft. from W. Line

PAWNEE ROCK POOL

Location Rig up

Drilling and Remarks:

Pl 23738.2" @ 3808Water.

:

RECORD

Cased in., ft.Sand Gas Oil Total Depth 3804

PRODUCTION

1st 24 hrs. Nat. 1st 24 hrs. after shot Gas Cu. Ft.Dry Hole Abandoned

Date

AUG 27 1942 19 S. J. LEWIS Scout