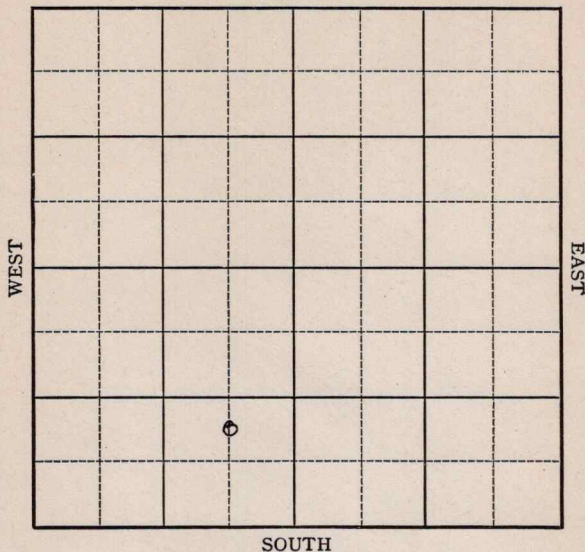


Section 12 Township 20 Range 16-W

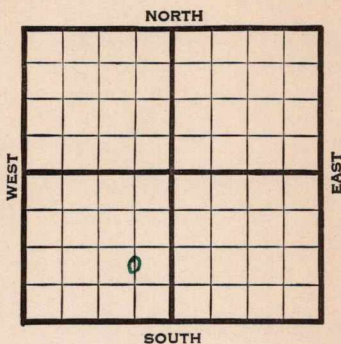
Well No. #2 Bowyer

Company Amerada Petroleum

NORTH Pawnee Rock Pool



Rice

KANSASSec. 12 Twp. 20 R. 16-WWell No. #2 Bowyer FarmAmerada Petroleum Company
(Pawnee) Ft. from N. Line990' Ft. from S. Line660' Ft. from E. Line Ft. from W. Line**Elev. 2075**

1941

REPORT

7/30

8" 696'

Drl g. 2380'

8/7

Drl g. 3600'

8/15

Lans. 3477' Arb. 3747'

Saturation 3805-25 T.D.

5" - 3825' RUST

8/21

8 shots 3823-31' 300 acid.

Flow 318 oil 14 hours.

8/27

Arb. 3747'

5" - 3825'

T.D. 3831'

11 shots 3821-24'

3 " 3823-24'

8 " 3821-23.

3000 acid.

Bomb potential 12,377 bbls.

Maximum 3000 bbls.

38. Gravity

COMPLETED

Map No. 81 Sec. 12 Twp. 20 R. 16WWell No. 2 BowyerAmerada Petroleum

Company

Contractor

FIRST REPORT

C N L SE SW

SECTION PLAT

Ft. from N. Line

990 Ft. from S. Line660 Ft. from E. Line

Ft. from W. Line

PAWNEE ROCK POOL

Location

Rig up

Drilling and Remarks:

8" - 696

Drlg. 2380

RECORD

Cased _____ in., _____ ft.

Sand _____

Gas _____

Oil _____

Total Depth _____

PRODUCTION

1st 24 hrs. Nat. _____

1st 24 hrs. after shot _____

Gas _____ Cu. Ft.

Dry Hole _____

Abandoned _____

Date

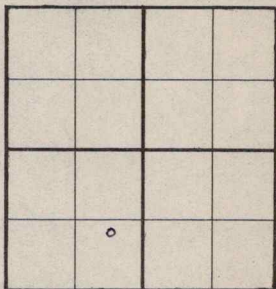
JUL 3 0 1941 19

S. J. LEWIS Scout

Map No. 81 Sec. 12 Twp. 20 R. 16WWell No. 2 BowyerAmerada Petroleum CompanyCOMPLETED Contractor

SECTION PLAT

C N L SE SW

 Ft. from N. Line990 Ft. from S. Line660 Ft. from E. Line Ft. from W. Line

PAWNEE ROCK POOL

Location Rig up

Drilling and Remarks:

*Ar Y 3747**5 " @ 3825-**11 shot to 3821-24**3 " 3823-24**8 " 3821-23**8000 acid**Bom & Ar Y 12377**Max 8000*Date *380 Gr*

RECORD

Cased in., ft.Sand Gas Oil Total Depth 3831

PRODUCTION

1st 24 hrs. Nat. 1st 24 hrs. after shot Gas Cu. Ft.Dry Hole Abandoned

AUG 27 1941

19

S. J. LEWIS

Scout