


# KANSAS

FORM 51 5M 4-41 PETROL

Section 12 Township 20 Range 16-W

Well No. 1 Smith

Company British American

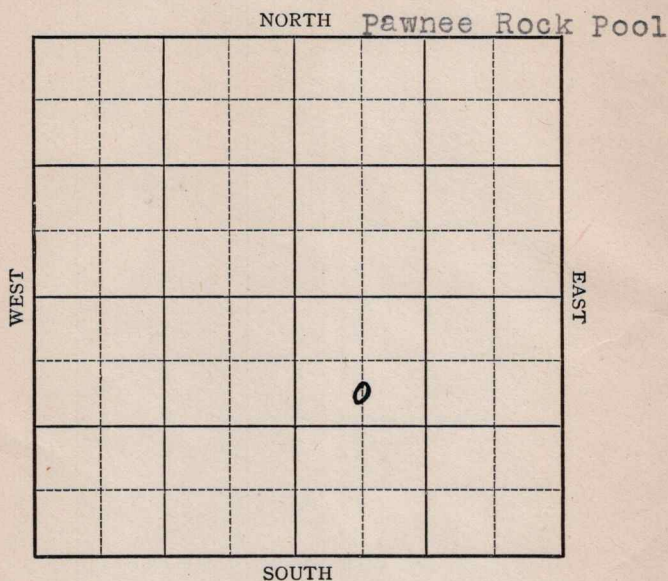

Elev. 2067

[illegible]

751914

1941

10/15

Arb. 3744'

5" - 3821'

T.D. 3821'

16 shots 3814-16 $\frac{1}{2}$ '

300 acid.

Potential 402 bbls., flow.

38. Gravity

COMPLETED

Map No. 81 Sec. 12 Twp. 20 R. 16WWell No. 1 Smith

British American

Company


FIRST REPORT

Contractor

C S L NW SE

990 Ft. from N. Line       Ft. from S. Line       Ft. from E. Line660 Ft. from W. Line

## SECTION PLAT

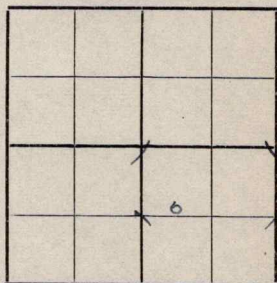

PAWNEE ROCK POOL

Location XRig up       

Drilling and Remarks:

Drlg. 400

## RECORD

Cased        in.,        ft.Sand       Gas       Oil       Total Depth       

## PRODUCTION

1st 24 hrs. Nat.       1st 24 hrs. after shot       Gas        Cu. Ft.Dry Hole       Abandoned       

Date

AUG 27 1941 19

S. J. LEWIS

Scout

Pawnee

KANSAS

Map No. 4-P1 Sec. 12 Twp. 20 R. 16WWell No. 1 Smith

British American

Company

COMPLETED

Contractor

C S L NW SE

990 Ft. from N. Line

\_\_\_\_\_ Ft. from S. Line

\_\_\_\_\_ Ft. from E. Line

660 Ft. from W. Line

## SECTION PLAT

|  |  |  |  |
|--|--|--|--|
|  |  |  |  |
|  |  |  |  |
|  |  |  |  |
|  |  |  |  |

PAWNEE ROCK POOL

Location \_\_\_\_\_

Rig up \_\_\_\_\_

Drilling and Remarks:

*Cr 83744**5' to 3821**16 shots 3814-16 1/2**300 acut**Flow 40287**38° Gr.*

## RECORD

Cased \_\_\_\_\_ in., \_\_\_\_\_ ft.

Sand \_\_\_\_\_

Gas \_\_\_\_\_

Oil \_\_\_\_\_

Total Depth 3821

## PRODUCTION

1st 24 hrs. Nat. \_\_\_\_\_

1st 24 hrs. after shot \_\_\_\_\_

Gas \_\_\_\_\_ Cu. Ft.

Dry Hole \_\_\_\_\_

Abandoned \_\_\_\_\_

Date

OCT 15 1941

19

S. J. LEWIS

Scout