

KANSAS


Pawnee

FORM 51 5M 1-42 PETROL

Section 12 Township 20 Range 16-W

Well No. #1 Wickstrom

Company ~~Elbar Oil~~ BARBARA OIL & GAS

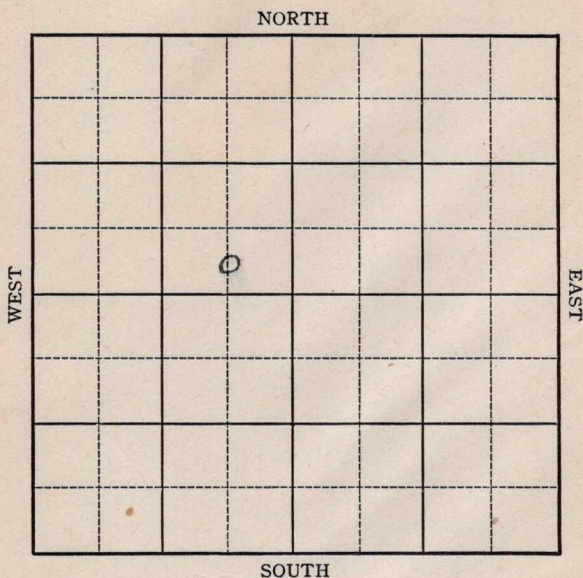

KANSAS


Pawnee

Sec. 12 Twp. 20 R. 16-W

Well No. #1 Wickstrom Farm

~~Elbar Oil~~ BARBARA OIL Company
GAS

NORTH

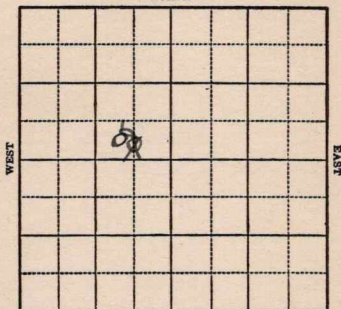

Ft. from N. Line

345

Ft. from S. Line

330

Ft. from E. Line

800
660

Ft. from W. Line

Elev. 2049 2045

SOUTH

REPORT

1944

1/5

Location.

1-12

"

1/19

"

2

1/26

Surface hole

2/2

"

"

2/8

"

"

2/15

Cong 3742

T_d 3802 in Cong

2/23

Cong 3742

TD 3802

ABANDONED

KANSAS

Map No. 8 / Sec. 12 Twp. 20 R. 16W

Well No. 1 Wickstrom

Elbar Oil Company

FIRST REPORT Contractor

C S L SE NW

SECTION PLAT


 Ft. from N. Line

330 Ft. from S. Line

660 Ft. from E. Line

 Ft. from W. Line

Pawnee Rock Pool

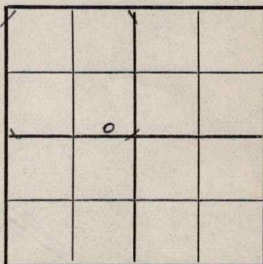

Location **X**

Rig up

Drilling and Remarks:

RECORD

Cased in., ft.

Sand

Gas

Oil

Total Depth

PRODUCTION

1st 24 hrs. Nat.

1st 24 hrs. after shot

Gas Cu. Ft.

Dry Hole

Abandoned

Date

JAN 5 1944

19

S. J. LEWIS


Scout

KANSASMap No. 8 Sec. 12 Twp. 20 R. 16WWell No. 1 WickstromBarbara Oil & Gas CompanyCORRECTION

Contractor

C S L SE NW

SECTION PLAT

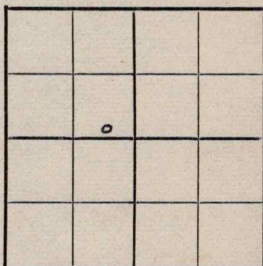 Ft. from N. Line330 Ft. from S. Line660 Ft. from E. Line Ft. from W. LinePawnee Rock PoolLocation Rig up

Drilling and Remarks:

Reported as
Elbar Oil

RECORD

Cased in., ft.Sand Gas Oil Total Depth

PRODUCTION

1st 24 hrs. Nat. 1st 24 hrs. after shot Gas Cu. Ft.Dry Hole Abandoned

Date

JAN 1 2 1944 19S. J. LEWIS Scout

Map No. ~~KANSAS~~ Sec. 12 Twp. 20 R. 16WWell No. 1 WickstromBarbara Oil & Gas


Company

CORRECTION

Contractor

SW SE NW

SECTION PLAT

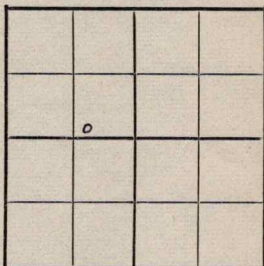 Ft. from N. Line345 Ft. from S. Line800 Ft. from E. Line Ft. from W. LinePawnee Rock PoolLocation Rig up

Drilling and Remarks:

Reported

C S L SE NW

RECORD

Cased in., ft.Sand Gas Oil Total Depth

PRODUCTION

1st 24 hrs. Nat. 1st 24 hrs. after shot Gas Cu. Ft.Dry Hole Abandoned

Date

JAN 26 1944

19

S. J. LEWIS

Scout


Map No. 87 **KANSAS** Sec. 12 Twp. 20 R. 16W
Well No. 1 Wickstrom

Barbara Oil & Gas Company

ABANDONED Contractor

SW SE NW

SECTION PLAT

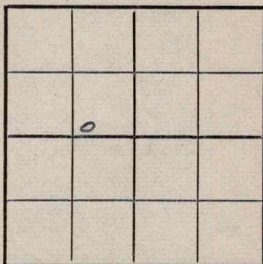

_____ Ft. from N. Line

345 Ft. from S. Line

800 Ft. from E. Line

_____ Ft. from W. Line

Pawnee Rock Pool

Location _____

Rig up _____

Drilling and Remarks:

Core 3742

3702 in Core

RECORD

Cased _____ in., _____ ft.

Sand _____

Gas _____

Oil _____

Total Depth 3802

PRODUCTION

1st 24 hrs. Nat. _____

1st 24 hrs. after shot _____

Gas _____ Cu. Ft.

Dry Hole _____

Abandoned _____

Date

FEB 23 1944 19

S. J. LEWIS Scout