

KANSAS

Greenwood

FORM 51 5M PETROL

Section 26 Township 24 Range 12E

Well No. 2 Lane

Company Becker & Stewart

NORTH

0							

SOUTH

WEST

EAST

KANSAS

Greenwood County
24 R. 12E

Sec. 26 Twp. Farm

Well No. 2 Lane Farm

Becker & Sterwart Company

Virgil
990

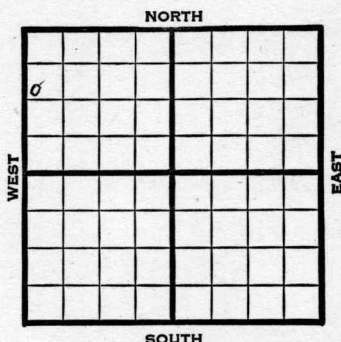
Ft. from N. Line

Ft. from S. Line

Ft. from E. Line

330

Ft. from W. Line



SW NW NW

REPORT

1945

5/2 machine
5/10 10" @ 350
Drlg. 700'
5/17 8" @ 970
Miss. 1632
TD 1639
Run 5"
5/24 5" @ 1655 TD
220' oil 11 hrs.
6/6 Miss. 1632
5" @ 1644
TD 1656
1000 acid.
Pump 15 Pot.
Grav. 38.0

COMPLETED

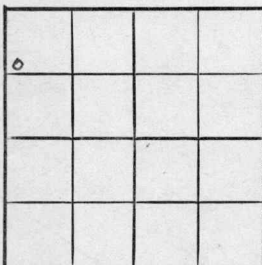
Kansas Pool Name VirgilMap No. 10 Sec. 26 Twp. 24 R. 12EWell No. 2 LaneBecker & Stewart Company

FIRST REPORT

Contractor

SW NW NW

SECTION PLAT

990 Ft. from N. Line Ft. from S. Line Ft. from E. Line330 Ft. from W. LineGreenwood CountyLocation Rig up Drilling and Remarks:
machine

RECORD

Cased in., ft.Sand Gas Oil Total Depth

PRODUCTION

1st 24 hrs. Nat. 1st 24 hrs. after shot Gas Cu. Ft.Dry Hole Abandoned

Date

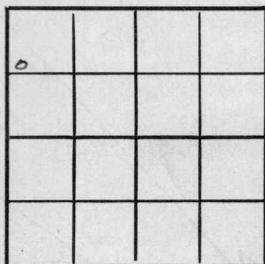
MAY 2 194519S. J. LEWISScout

Kansas Pool Name VirgilMap No. 16 Sec. 26 Twp. 24 R. 12EWell No. 2 LaneBecker & Stewart Company**COMPLETED**

Contractor

SW NW NW

SECTION PLAT

990 Ft. from N. Line Ft. from S. Line Ft. from E. Line330 Ft. from W. LineGreenwood CountyLocation Rig up

Drilling and Remarks:

*11/15/1632**5" @ 644**1000 ac. C**Pump 15 Bx**38° 44'*

RECORD

Cased in., ft.Sand Gas Oil Total Depth 1656

PRODUCTION

1st 24 hrs. Nat. 1st 24 hrs. after shot Gas Cu. Ft.Dry Hole Abandoned

Date

JUN 6 1945 19

S. J. LEWIS Scout