


Map No. Kansas Sec. 28 Twp. 24 R. 12
Well No. 2 Morris Farm
Kettle et al Company

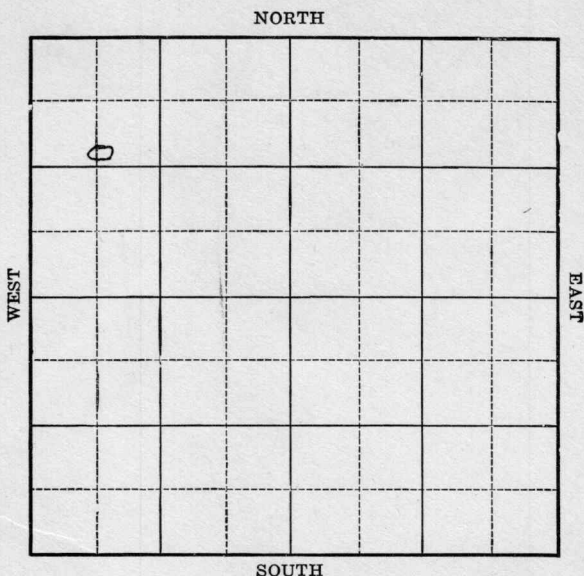

Location _____
Drilling Remarks _____

Rig Up _____
Drilling Remarks _____

RECORD

Cased _____ in. _____ ft.
Sand _____
Gas _____
Oil _____
Total Depth _____


PRODUCTION

1st 24 hrs. Nat. _____
1st. 24 hrs. after shot _____
Gas _____ cu. ft.
Dry Hole _____
Abandoned _____

Map No. Kansas Sec. 28 Twp. 24 R. 12Well No. 2 Morris FarmKettle et al Company1120 Ft. from N. Line

Ft. from S. Line

Ft. from E. Line

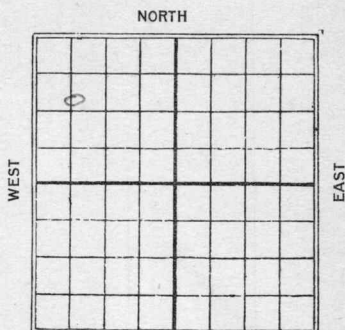660 Ft. from W. Line1st & Completed

Date

REPORT

19254/6Top Line 1685S. + Q. 1715'

16 **KANSAS** Sec. 28 Twp. 24 R. 12

Well No. 2 Morris

Little et al. Company

Contractor

ABANDONED

SECTION PLAT

1120' Ft. from N. Line

_____ Ft. from S. Line

_____ Ft. from E. Line

6600' Ft. from W. Line

0			

Location _____

Rig up _____

Drilling and Remarks:

Tap L. 1685

L & A

1715'

1st & Completed

RECORD

Cased _____ in., _____ ft.

Sand _____

Gas _____

Oil _____

Total Depth _____

PRODUCTION

1st 24 hrs. Nat. _____

1st 24 hrs. after shot _____

Gas _____ Cu. Ft.

Dry Hole _____

Abandoned _____

Date

APR 6 1925

M. A. BENEAR

192

Scout