


DX 78-1

Section 27 Township 20 Range 13W

Well No. 1 Engleman

Company Nate Appleman & C-G Drlg.

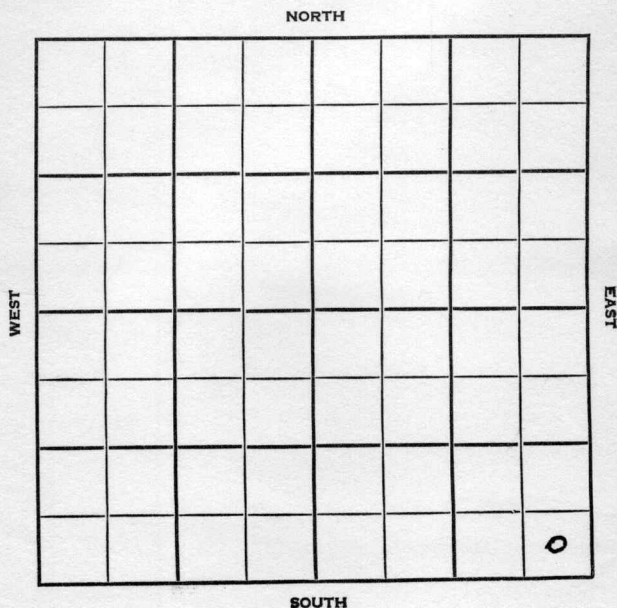

Barton KANSAS

SEC.	TWP.	R.
27	20	13W ✓
WELL NO.		
1 Engleman		FARM
COMPANY		
Nate Appleman		
CONTRACTOR		


Wildcat

_____ Ft. from N. Line

330 _____ Ft. from S. Line

330 _____ Ft. from E. Line

_____ Ft. from W. Line

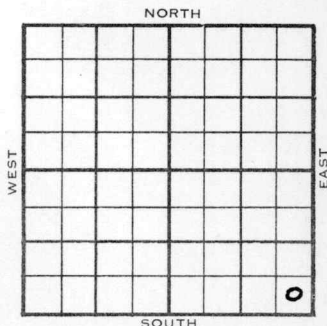

SE S¹ SE

CSO farmout

1954	ELEVATION	REPORT
	1877'	
6/15 6/23	Loc. 8" @ 274 w/200 Drlg. 1390'	
6/30	Heeb 3134 Br li 3249 Lans 3264 Cong. 3509 Arb. 3555 DST 3556-63, 1 hr, 165' gas, 205' oil 600# RTD 3563 5" @ 3557	
7/7	CO 3563 15 GOPH 500 A 37 GOPH 12 hrs. 1000 A No help frac. lost load. 3000 A S/wtr.	
7/14	Spud 6-19-54 - D&A TD 3563' 8" @ 274' Heeb 3134'; Br lime 3249', Lans 3264', Cong 3509', Arb. 3555' DST 3556-63, opn 1 hr., rec. 165' gas, 205' oil, 600# TD 3563' 5" @ 3557' CO to 3563' 15 goph 500A 37 goph 12hrs., 1000A Frac, 3000A wtr. D&A	

ABANDONED

County **Barton** State **Kansas**

Sec. 27 (Blk.) 20 (Sur.) 13W Map No.

Operator **Nate Appleman & C-G Drlg.**

Well No. **1** Farm **Engleman**

Elev.	Location	SE SE SE

FIRST REPORT

330 Ft. From S Line SE

330 Ft. From **E** Line Quarter

1st. Report **JUN 15 1954**

Completion

Remarks	CSO farmout
---------	-------------

Spudding Date _____

Drig. Data **Wildcat**

Location

J. G. McGEHEE

County Barton State Kansas
 Sec. 27 (Blk.) 20 (Sur.) 13W Map No.
 Operator Nate Appleman & C-G Drlg.
 Well No. 1 Farm Engleman
 Elev. 1877 Location SE SE SE



330 Ft. From S Line SE
330 Ft. From E Line Quarter

1st. Report

Completion JUL 14 1954

Remarks Wildcat

Spudding Date 6-19-54

Drlg. Data D & A TD 3563

8" @ 274 Heeb. 3134 Br. lime 3249

Lans. 3264 Cong. 3509 Arb. 3555

DST 3556-63 open 1 hr., rec. 165' gas

205' oil 600# TD 3563 5" @ 3557

CO to 3563 15 goph 500 A 37 goph

12 hr. 1000 A frac 3000 A wtr.

D & A

J. G. McGEHEE