


Section 27 Township 20 Range 13 W

Well No. # 3 Weathers

Company Schermerhorn Oil

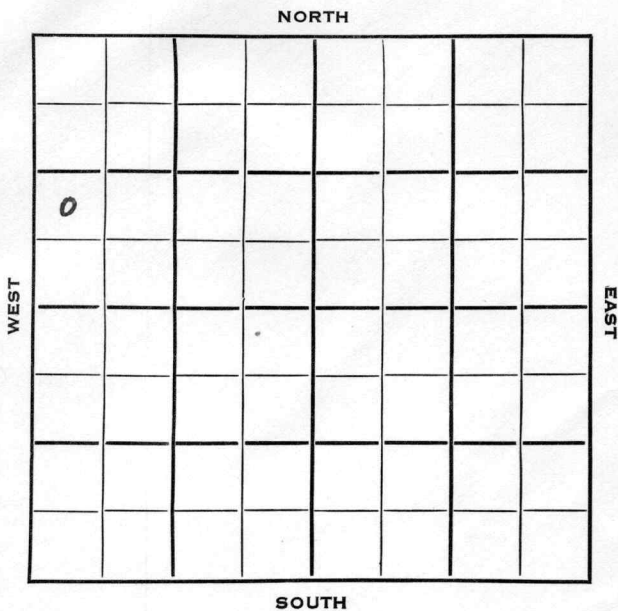

Sec. 27 Twp. 20 R. 13W

Well No. #3 Weathers Farm

Schermerhorn Oil Company


S. Sand Rock Pool Contractor

Ft. from N. Line

990 Ft. from S. Line

Ft. from E. Line

330 Ft. from W. Line
NW SW NW

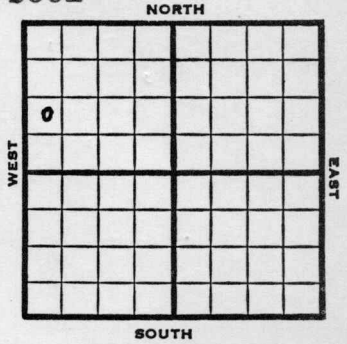

1952 Elev. 1881' REPORT

12/3 Location

12/11 "

12/18 Ø2720

12/25 Drlg 2720

1/1 Heeb 3107 Tor 3124 Doug 3143 Br1. 3223
Lans 3235 Cong 3470 Arb 3529 3551 TD 5"
@ 3482

1/8 NR

1/22 8/3362-64, 12/3367-70, 12/3379-83,
24/3389-3403, FU 3100'
oil 2 hrs., POP

1/29 NR

2/4 Spud 12-12-52

OilWell

TD 3551

8" @ 255

Heeb 3107, Tor 3124, Doug 3143,
Br lime 3223, Lans 3235

DST 3233-3300, opn 20 mins., rec.
4 mcfg, 30' gcm, 285' o & gcm,
15' oil, 1190#

DST 3309-3329, opn 1 hr., rec.
140' o & gcm, 1000#

DST 3353-84, opn 1 hr., rec. 30'
o & gcm, 120' oil, 320' clean
oil 570#

OVER

#3 Weathers
(Information Brought Forward)

1953

2/4 DST 3384-3404, opn 1 hr., rec.
2070' clean oil 730#
DST 3404-29, opn 1 hr., rec. 15'
mud, 0#
Cong 3470, Arb. 3529, PreCamb.
3548
DST 3533-51, opn 1 hr., rec.
5' mud,
5" @ 3482
8/3362-64, 12/3367-70, 12/3379-83
24/3389-3403,
FU 3100' oil
Comp. 261 bopd

COMPLETED

County **Barton** State **Kansas**

Sec. **27** (Blk. Twp.) **20** (Sur. Rge.) **13W** Map No.

Operator **Schermerhorn Oil**

Well No. **3** Farm **Weathers**

Elev. Location **NW SW NW**

0							
FIRST REPORT							

990 Ft. From **S** Line **NW**

330 Ft. From **W** Line Quarter

1st. Report **DEC 3 1952**

Completion

Remarks

Spudding Date

Drlg. Data **S. Sand Rock Pool**

Location

County Barton State Kansas

Sec. 27 (Blk. 20) (Sur. 13W) (Twp.) (Rge.) Map No.

Operator Schermerhorn Oil

Well No. 3 Farm Weathers

Elev. 1881 Location NW SW NW

990 Ft. From S Line NW

330 Ft. From W Line Quarter

Ist. Report

Completion FEB 4 1952

Remarks S. Sand Rock Pool

Spudding Date 12-12-52

Drlg. Data Oil well TD 3551

8" @ 255 Heeb. 3107 Tor. 3124

Doug. 3143 Br. lime 3223 Lans. 3235

DST 3233-3300 open 20 min. Rec. 4 mcfg

30' gcm 285' o & gcm 15' oil 1190#

DST 3309-3329 open 1 hr. Rec. 140' o &

gcm 1000# DST 3353-84 open 1 hr.

Rec. 30' o & gcm 120' oil 320' clean

oil 570# DST 3384-3404 open 1 hr.

Rec. 2070' clean oil 730# DST 3404-29

open 1 hr. Rec. 15' mud 0#

Cong. 3470 Arb. 3529 PreCamb. 3548

DST 3533-51 open 1 hr. Rec. 5' mud

5" @ 3482 8/ 3362-64 12/ 3367-70

12/ 3379-83 24/ 3389-3403 FU 3100' oil

Comp. 261 bopd

J. G. McGEHEE