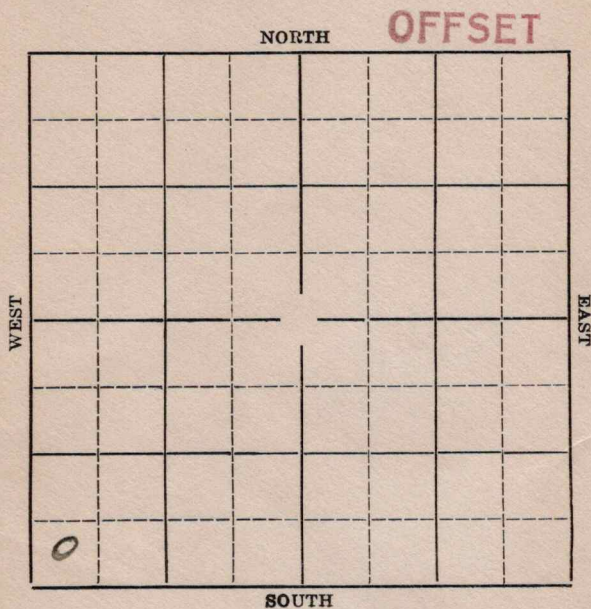



Section 13 Township 20 Range 16-WWell Number #1 Martha GatesCompany Simpson Oil et al

Map No. **KANSAS** Sec. **13** Twp. **20** R. **16W**Well No. **#1 Martha Gates** Farm**Simpson Oil et al** Company

Ft. from N. Line

330' Ft. from S. Line

Ft. from E. Line

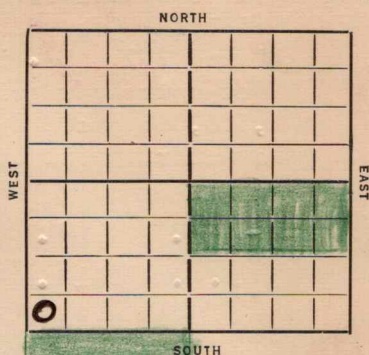330' Ft. from W. Line**Elev. 2087**Date **1936** **OFFSET** REPORT

7/15 Location
7/23 Building rig.
7/30 Rigging up.
8/6 Drlg. 850'.
8/13 Drlg. 1520'. 13" 650
8/20 Drlg. 3215'. 7" 3819
8/24 **Top Siliceous 3815**
 Drilled to 3825
 Small show oil thru cuttings
 Cored 3825-41 Recovered 6 feet
 Good saturation Think Pay 3832-41
 Running pipe 3815 Rust (Tel)
8/27 --
9/1 Drilled plug Spray oil Estimate 3 to 5
 M Gas Flowing by heads
 Shut in to build tankage (Tel)
9/3 Shut in Build tanks (Tel)
9/11 Hole cleaned out to bottom
 Will acidize with 2500 gallons (Tel)

(OVER)

751969

9/16--Top Siliceous 3815 T.D. 3841

Old potential 187 bbls. natural

Acidized with 2500 gallons acid

Flowed 257 bbls. in 24 hours

Last hour averaged 7 bbls. per hour

1,300,000 gas 280# rock pressure

No water Oil 36 Gravity (Tel)

9/23/36-Sil. 3815'.

T.D. 3841'.

2500 Gallons of acid.

1,300,000 cuft of gas.

257 bbls of oil flowing.

COMPLETED

Map No. 81 Sec. 13 Twp. 20 R. 16W

Well No. 1 Martha Gates

Simpson Oil & Gas Company

Contractor

SECTION PLAT

0			

 Ft. from N. Line

330 Ft. from S. Line

 Ft. from E. Line

330 Ft. from W. Line

FIRST REPORT

Location ✓

Rig up

Drilling and Remarks:

RECORD

Cased in., ft.

Sand

Gas

Oil

Total Depth

PRODUCTION

1st 24 hrs. Nat.

1st 24 hrs. after shot

Gas Cu. Ft.

Dry Hole

Abandoned

Date

JUL 15 1936 19

S. J. LEWIS

Scout

KANSAS

Map No. 81 Sec. 13 Twp. 20 R. 16WWell No. 1 Martha GatesSimpson Oil & Gas Company

Contractor

SECTION PLAT

0			

 Ft. from N. Line330 Ft. from S. Line Ft. from E. Line330 Ft. from W. Line

COMPLETED

Location Rig up

Drilling and Remarks:

Oil 3815'
2500 acid
1,300,000 cu. Gas
257 Oil flow

RECORD

Cased in., ft.Sand Gas Oil Total Depth 3841

PRODUCTION

1st 24 hrs. Nat. 1st 24 hrs. after shot Gas Cu. Ft.Dry Hole Abandoned

Date

SEP 23 1936 19S. J. LEWIS Scout