


Section 28 Township 20 Range 13 W

Well No. # 2 Jackson

Company Schermerhorn Oil

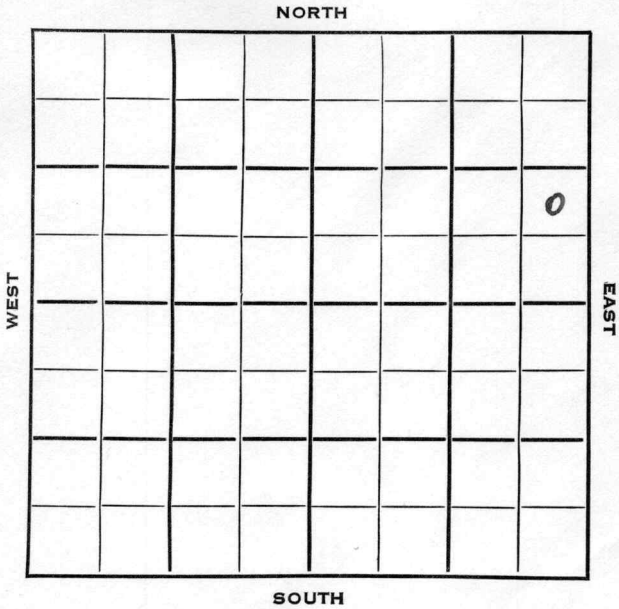

Sec. 28 Twp. 20 R. 13W

Well No. #2 Jackson Farm \_\_\_\_\_

Schermerhorn Oil Company \_\_\_\_\_

Contractor \_\_\_\_\_


\_\_\_\_\_ Ft. from N. Line

990 Ft. from S. Line

330 Ft. from E. Line

\_\_\_\_\_ Ft. from W. Line

NE SE NE

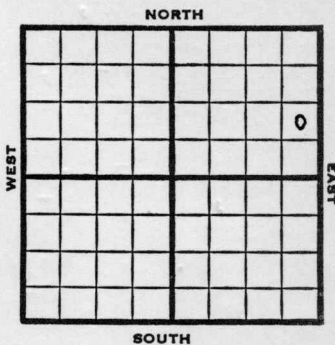

1952 Elev. 1887' REPORT

12/3 Location

12/11 NR

12/18 Heeb 3117 Doug 3156 Br 1 3235 Lans 3247  
 Dst 3271-3318 50 Mins. F Oil in 45 mins  
 DST 3319-46 1 Hr. 60' HO & GCM 480'  
 frothy oil 650# DST 3325-46 1 Hr. 30'  
 O&GCM 110' Oil 700# DST 3371-3404 1 Hr.  
 700' free oil 440' Ho & GCM Ø ahead.

12/25 " " "

1/1 Cong 3512 Arb 3582 TD 3596 DST double  
 packer 3428-42 1 Hr. 1740' gas in pipe  
 250' grsy oil 1010# 7" @ 3535

1/8 NR

1/22 NR

1/29 NR

2/4 Spud 12-7-52  
 Oil Well  
 TD 3596  
 10" @ 270  
 Heeb 3117, Doug 3156, Br lime  
 3235, Lans 3247  
 DST 3271-3318, opn 50mins.,  
 F/oil in 45 mins.  
 DST 3319-46, opn 1 hr., rec. 60'

OVER

#2 Jackson

(Information Brought Forward)

1953

2/4 ho & gcm, 480' frothy oil, 650#  
DST 3325-46, opn 1 hr., rec. 30'  
o & gcm, 110' oil, 700#  
DST 3371-3404, opn 1 hr., rec.  
700' free oil, 440' ho & gcm, 700#  
Cong 3512, Arb. 3582  
TD 3596  
DST 3428-42, opn 1 hr., rec.  
1740' gas, 250' gassy oil, 1010#,  
7 @ 3535  
12/3381-83, 12/3397-99, 66/3409-  
201, 30/3433-38, S/62 bo 2½ hrs.  
~~5100~~ 1000A  
Comp. 283 bopd

COMPLETED



