


Section 28 Township 20 Range 13 W

Well No. # 3 Jackson

Company Schermerhorn Oil

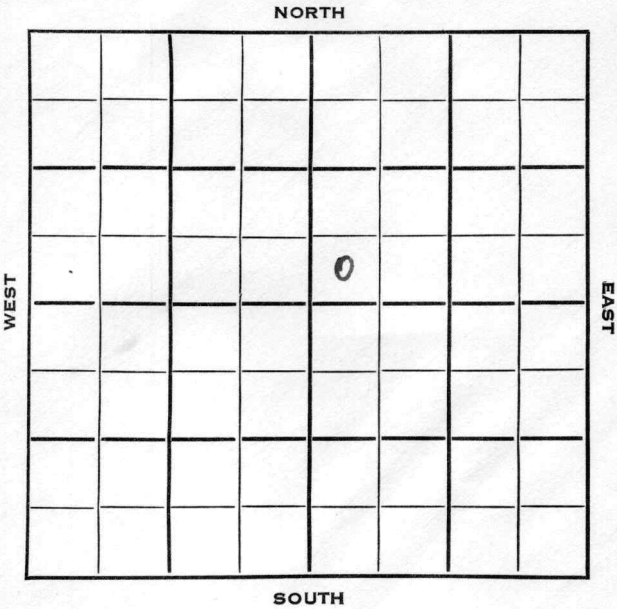

Barton

KANSAS ✓

Sec. 28 Twp. 20 R. 13 WWell No. # 3 Jackson FarmSchermerhorn Oil


Company

Badger Drlg.

Contractor

Sandrock Pool Ft. from N. Line330 Ft. from S. Line Ft. from E. Line330 Ft. from W. Line

SW SW NE

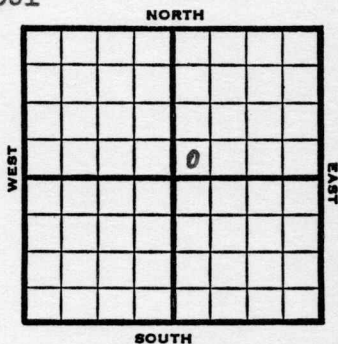

1953

Elev. 1886'

REPORT

8/26

Spud 8-22-53

8" @ 178 WOC

9/9

WOC

9/16

Spud 8-22-53

D&A

TD 3597½

8" @ 178

Heeb 3143, Br line 3262, Lans 3274

DST 3399-3420, opn 1 hr., rec. 5' mud
O#

Cong 3516, Gr 3597

TD 3597½

D&A

ABANDONED


County Barton State KansasSec. 28 (Blk.) 20 (Sur. Rge.) 13W Map No.Operator Schermerhorn OilWell No. 3 Farm JacksonElev. Location SW SW NE330 Ft. From S Line NE330 Ft. From W Line Quarter1st. Report AUG 26 1953

Completion

Remarks

Badger Drlg. - Contr.Spudding Date 8-22-53Drlg. Data Sandrock Pool8" @ 178 WOC

County Barton State Kansas
 Sec. 28 (Blk.) 20 (Sur.) 1 3W Map No.
 Operator Schermerhorn Oil
 Well No. 3 Farm Jackson
 Elev. 1886 Location SW SW NE

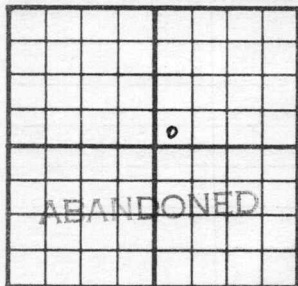

330Ft. From S Line NE
330Ft. From W Line Quarter

1st. Report

Completion SEP 16 1953

Remarks Sandrock Pool
Badger Drlg. - Contr.

Spudding Date 8-22-53

Drlg. Data D & A TD 3597 $\frac{1}{2}$

8" @ 178 Heeb. 3143 Br. lime 3262

Lans. 3274 DST 3399-3420 open 1 hr.

Rec. 5' mud 0# Cong. 3516 Gr. 3597

TD 3597 $\frac{1}{2}$

D & A