

KANSAS


Section 12 Township 20 Range 16W

Well No. 4 Wickstrom

Company Campbell & Kuhn

Pawnee

NORTH

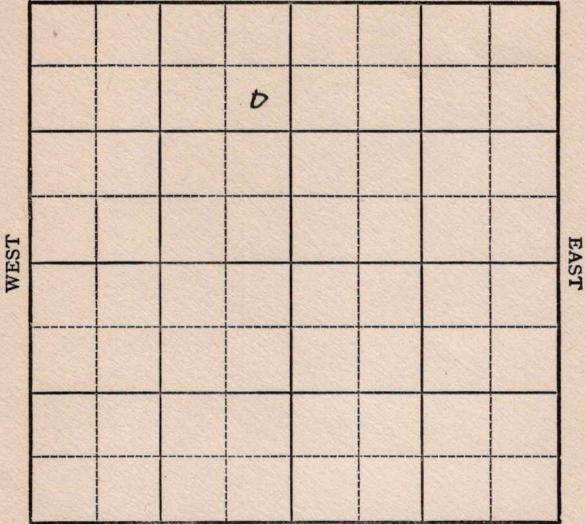

SOUTH

Sec. 12 Twp. 20 R. 16W

Well No. #4 Wickstrom Farm

Campbell & Kuhn Company


Pawnee (Campbell, Cont.)
Rock

990' Ft. from N. Line

 Ft. from S. Line

330' Ft. from E. Line

 Ft. from W. Line

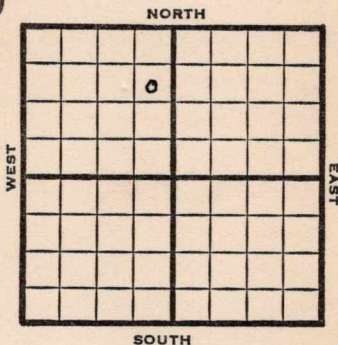

SE NE NW

1949

Elev 2017'

REPORT

5/18

Anhy 1027'

8" @ 1027'

Drlg. 3004'

5/25

Lans. 3412'

Arb. 3618'

TD 3742'

5" @ 3741'

6/1

"

6/7

"

6/15

"

6/21

"

6/28

"

7/6

"

7/12

"

7/20

"

7/27

TD 3748'

1500 acid

Swb 10 oil a day 3 M Gas

8/3

"

8/10

"

8/17

"

8/24

"

8/31

"

9/7

"

9/14

"

9/21

"

9/28

"

10/5

"

OVER

1949

751978

10/12 TD 3748'
Arb. 3618'
5"@ 3741'
1500 acid
Flow 17 oil Pot
39° Gr.
Comp

COMPLETED

Kansas

Map No. _____ Sec. 12 Twp. 20 R. 16W

Well No. 4 Wickstrom

Campbell & Kuhn Company

Campbell Contractor

SE NE NW

FIRST REPORT
SECTION PLAT

990 Ft. from N. Line

_____ Ft. from S. Line

330 Ft. from E. Line

_____ Ft. from W. Line

	D		

Pawnee County

Location _____

Rig up _____

Drilling and Remarks:

Anhy 1027

8" @ 1027

drlg. 3004

RECORD

Cased _____ in., _____ ft.

Sand _____

Gas _____

Oil _____

Total Depth _____

PRODUCTION

1st 24 hrs. Nat. _____

1st 24 hrs. after shot _____

Gas _____ Cu. Ft.

Dry Hole _____

Abandoned _____

Date

MAY 18 1949 19

S. J. LEWIS Scout

Map No. _____ Sec. 12 Twp. 20 R. 16W

Well No. 4 Wichstrom

Campbell & Kuhn Company

COMPLETE

Contractor

SE NE NW

E. 2012
SECTION PLAT

990 Ft. from N. Line

_____ Ft. from S. Line

330 Ft. from E. Line

_____ Ft. from W. Line

	o		

Pawnee County

Location _____

Rig up _____

Drilling and Remarks:

Art 3618.
5" 02741
1500 acid
Flow 1700 BT

29 3/4

RECORD

Cased _____ in., _____ ft.

Sand _____

Gas _____

Oil _____

Total Depth 2747.

PRODUCTION

1st 24 hrs. Nat. _____

1st 24 hrs. after shot _____

Gas _____ Cu. Ft.

Dry Hole _____

Abandoned _____

Date

OCT 12 1949

19

S. J. LEWIS

Scout