

Barton


KANSAS

Section 28 Township 20 Range 13 WWell No. # 4 Purcel *(Pursell)*Company Phillips Petroleum ?

NORTH

WEST

EAST

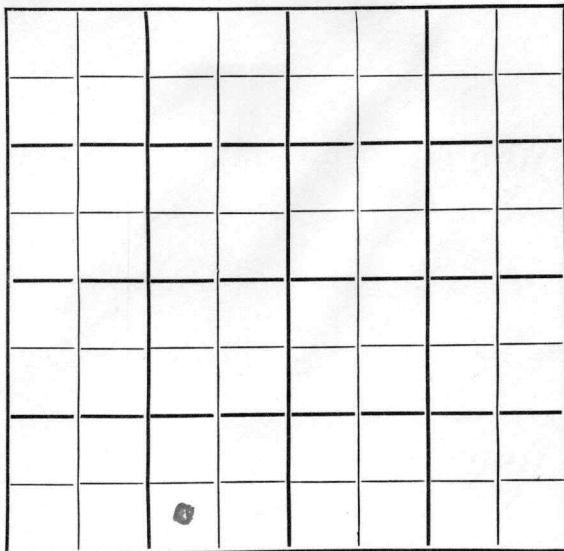

SOUTH

SEC.	TWP.	R.
28	20	13W ✓

WELL NO.

4 Purcel

FARM

COMPANY

Phillips Petr.

CONTRACTOR

Phillips

Sandrock Pool

Ft. from N. Line

330


Ft. from S. Line

990

Ft. from E. Line

Ft. from W. Line

SW SE SW

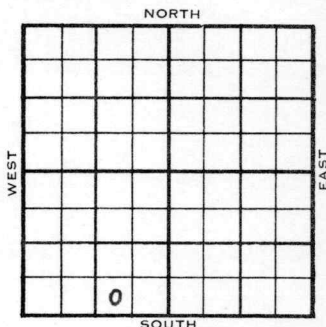

1953

ELEVATION

1889'

REPORT

11/24

Location

12/9

8" @ 361'

Heeb 3143', Br li 3262', Lans 3276'

DST 3405'-18', 1 hr., 60' gas, 50'

HOCM, 705#

RTD 3515 Schl

5" @ 3514'

1954

1/6

Spud 11-26-53

Oil Well

TD 3515'

8" @ 361'

Heeb 3143', Br. Lime 3262', Lans 3276'

DST 3405'-18' opn 1 hr, rec 60' gas,

50' hocm 705#

TD 3515'

5" @ 3514'

CO to 3475

16/ 3465-69 B/ $\frac{1}{2}$ bo 3 hr. 500 A

S/ 11.7 bw 2 hr. PB 3436 20/ 3404-09


500 A S/ 34.8 bo 80.8 bw 16 $\frac{1}{2}$ hr

2500 A S/ 4 bo 36.35 bw 10 hr.

Comp 6 bopd 80% wtr.

COMPLETED

County Barton State Kansas
 Sec. 28 (Blk.) 20 (Sur.) 13W Map No.
 (Twp.) (Rge.)
 Operator Phillips Pet.
 Well No. 4 Farm Purcell
 Elev. 1889 Location SW SE SW

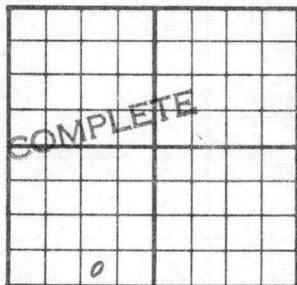

330 Ft. From S Line SW
990 Ft. From E Line Quarter

1st. Report

Completion JAN 6 1954

Remarks Sandrock Pool
Phillips - Contr.

Spudding Date 11-26-53

Drlg. Data Oil well TD 3515

8"@ 361 Heeb. 3143 Br. lime 3262

Lans. 3276 DST 3405-18 open 1 hr.

Rec. 60' gas 50' hoem 705#

TD 3515 5" @ 3514 CO to 3475

16/ 3465-69 B/ $\frac{1}{2}$ bo 3 hr. 500 A

S/ 11.7 bw 2 hr. PB 3436 20/ 3404-09

500 A S/ 34.8 bo 80.8 bw 16 $\frac{1}{2}$ hr.

2500 A S/ 4 bo 36.35 bw 10 hr.

Comp. 6 bopd 80% wtr.

J. G. McGEHEE