

Pawnee


KANSAS

Section 13 Township 20 Range 16-W

Well No. 1 Belt "A"

Company Hall-Jordan Kessler

NORTH Pawnee Rock pool

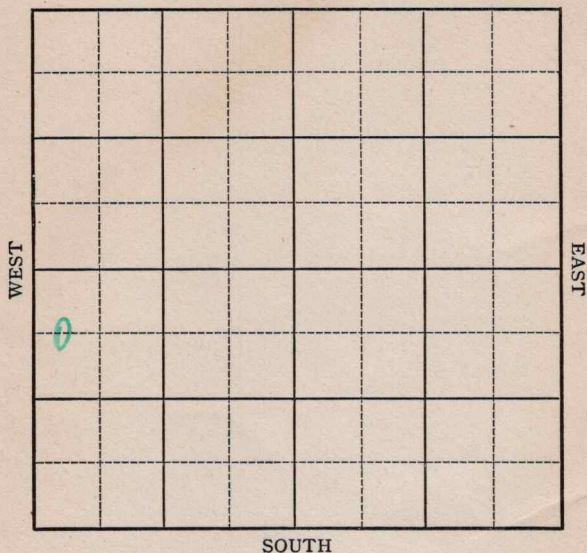


KANSAS

Pawnee

Sec. 13 Twp. 20 R. 16-WWell No. #1 Belt "A" FarmHall - Jordan Company

(Pawnee Rock)

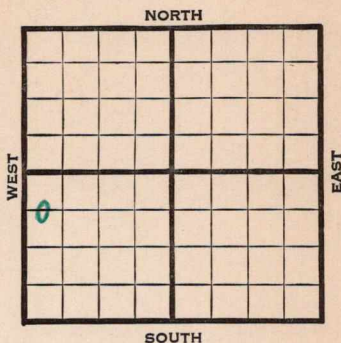660 Ft. from N. Line Ft. from S. Line Ft. from E. Line330 Ft. from W. Line

Elev. 2096

1941

REPORT

9/24

Derrick.

10/2

Drlg. 800'

10/9

12" - 650' Drlg. 3568'

10/16

5" - 3882' Arb. 3812'????

T.D. 3884' RUST.

10/23

19 shots 3833-36'

2 " 3832-33' 400 acid.

Water. Squeezed off perf.

10/30

24 shots 3824-29' 3000 acid.

11/5

Arb. 3832'

5" - 3882'

T.D. 3884'

24 shots 3824-29'

3000 acid.

Water.

ABANDONED

Map No. K-81 Sec. 13 Twp. 20 R. 16WWell No. 1 Belt "A"Hall- Jordan CompanyFIRST REPORT Contractor

C WL NW SW

SECTION PLAT

660 Ft. from N. Line Ft. from S. Line Ft. from E. Line330 Ft. from W. Line

PAWNEE ROCK POOL

Location Rig up

Drilling and Remarks:

Derrick20 acres.

RECORD

Cased in., ft.Sand Gas Oil Total Depth

PRODUCTION

1st 24 hrs. Nat. 1st 24 hrs. after shot Gas Cu. Ft.Dry Hole Abandoned

Date


SEP 24 194119S. J. LEWIS Scout

791997

Is this correct?

We show Stanolind have 3 wells on
this N/2 SW. Don Schumaker

SECTION PLAT

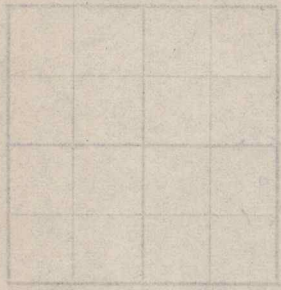

RECORD

- Misc. Small Maps
- Cards
- Tracing
- France Map
- Scarborough Map
- Moody Map
- Geological Dept.
- Moody Plat Book

Handwritten signatures and initials in blue and black ink, including 'DAS' and 'WAC'.

Pawnee

KANSAS

Map No. K-81 Sec. 13 Twp. 20 R. 16WWell No. 1 Belt "A"Hall-Kessler CompanyCORRECTION Contractor

C WL NW SW

660 Ft. from N. Line Ft. from S. Line Ft. from E. Line330 Ft. from W. Line

SECTION PLAT

o			

PAWNEE ROCK POOL

Location Rig up

Drilling and Remarks:

RECORD

Cased in., ft.Sand Gas Oil Total Depth

PRODUCTION

1st 24 hrs. Nat. 1st 24 hrs. after shot Gas Cu. Ft.Dry Hole Abandoned


Date

OCT 22 1941 19 S. J. LEWIS Scout

Map No. #-81 Sec. 13 Twp. 20 R. 16WWell No. 1 Belt "A"Hall-Kessler CompanyABANDONED Contractor

C WL NW SW

SECTION PLAT

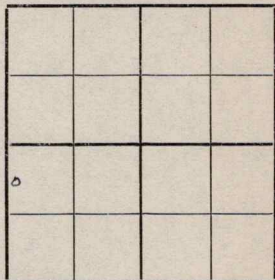660 Ft. from N. Line Ft. from S. Line Ft. from E. Line330 Ft. from W. Line

PAWNEE ROCK POOL

Location Rig up

Drilling and Remarks:

CR 83832
5 "C 3882
24 shot to 3824-29
3000 acid
Water.

RECORD

Cased in., ft.Sand Gas Oil Total Depth 3884

PRODUCTION

1st 24 hrs. Nat. 1st 24 hrs. after shot Gas Cu. Ft.Dry Hole Abandoned

Date

NOV 5 1941 19

S. J. LEWIS Scout