

KANSAS

Barton

Section 31 Township 20 Range 13WWell No. #3 BenjaminCompany Petroleum, Inc.

NORTH

WEST

EAST

							0

SOUTH

Barton

KANSAS

Sec. 31 Twp. 20 R. 13W ✓

Well No. #3 Benjamin Farm

Petroleum, Inc. Company

Garvey Oil - Contr. Contractor

Hiss Pool


 Ft. from N. Line

990' Ft. from S. Line

330' Ft. from E. Line

 Ft. from W. Line

NE SE SE

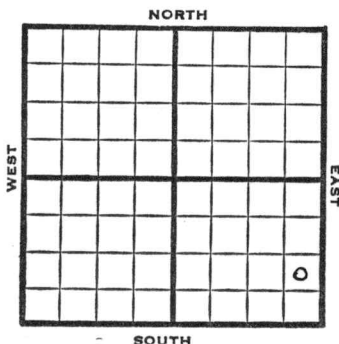

1951


Elev. 1910' REPORT

3/7

Spud 3-2-51
8" @ 219
Anhy 797
Drlg. 2060'

3/14

Spud 3-2-51
D & A TD 3570
8" @ 219 Anhy 797, Heeb. 3185,
Br. lime 3300, Lans. 3310, Arb. 3565
DST 3565-70 open $\frac{1}{2}$ hr. Rec. 50' SW
D & A
ABANDONED

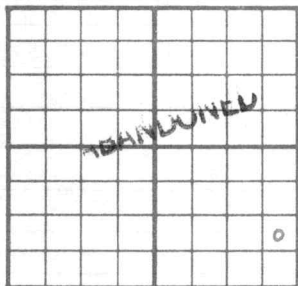County Barton State KansasSec. 31 (^{Blk.}Twp.) 20 (^{Sur.}Rge.) 13W Map No.Operator Petroleum Inc.Well No. 3 Farm BenjaminElev. 1910 Location NE SE SE990 Ft. From S Line SE330 Ft. From E Line Quarter

1st. Report

Completion MAR 14 1951Remarks Hiss PoolGarvey Oil - Contr.Spudding Date 3-2-51Drlg. Data D & A TD 35708" @ 219 Anhy 797 Heeb. 3185Br. lime 3300 Lans. 3310 Arb. 3565DST 3565-70 open $\frac{1}{2}$ hr. Rec. 50' swD & A

J. E. TYRA