

KANSAS

pawnee

FORM 51 5M 4-41 PETROL

Section 13 Township 20 Range 16-W

Well No. 1 Smith "A"


Company stanolind et al

pawnee Rock pool

NORTH

WEST

EAST

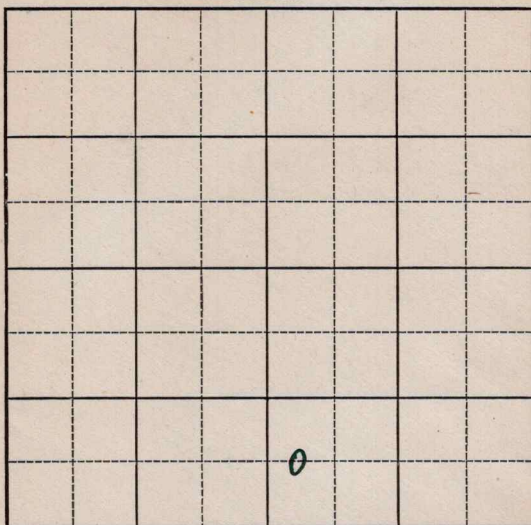

SOUTH

KANSAS


Pawnee

Sec. 13 Twp. 20 R. 16-WWell No. #1 Smith "A" FarmStanolind et al Company

(Pawnee Rock)

 Ft. from N. Line660 Ft. from S. Line Ft. from E. Line330 Ft. from W. Line

Elev. 2108

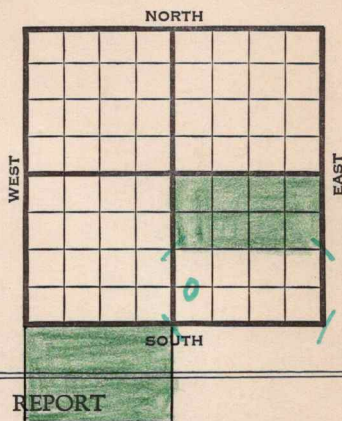

1941

REPORT

5/27

Location

6/5

"

6/12

8" - 665' Drlg. 670'

6/19

Anhy 1108' Drlg. 3082'

6/26

Arb. ~~3804'~~ T.D. ~~3871'~~ some

porosity & saturation. Run 5".

7/3

Arb. 3804' (Corrected)

5" - 3866' T.D. 3867' RUST.

7/7

Perf. 50 shots 3842-49 Flowed 41 bbls.

first hour open Ran tubing and
acidized with 500 gallons Shut in

Bldg. tanks (Tel)

7/17

52 shots 3842-49' 7000 acid.

Flow 9 bbls. oil per hour 6 hrs.

7/22

Waiting on state man to take potential

7/24

Tried to take a draw-down potential

Wouldn't stabilize Pumping potential

309 bbls. no water May perforate

some more or may deepen (Tel)

OVER

752039

1941

7/30.

Arb 3804'

TD 3867'

5" @ 3866'

52 shots 3842-49

12 shots 3838-42

2500 acid.

Pump 309 Potential

38. Gravity.

COMPLETED

Map No. 81 Sec. 13 Twp. 20 R. 16WWell No. 1 Smith "A"Stanolind etal CompanyFIRST REPORT Contractor


C W L S W S E

OFFSET

 Ft. from N. Line660 Ft. from S. Line Ft. from E. Line330 Ft. from W. Line

PAWNEE ROCK POOL

SECTION PLAT

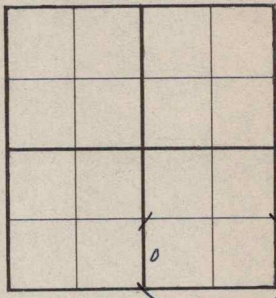Location XRig up

Drilling and Remarks:

RECORD

Cased in., ft.Sand Gas Oil Total Depth

PRODUCTION

1st 24 hrs. Nat. 1st 24 hrs. after shot Gas Cu. Ft.Dry Hole Abandoned

Date

MAY 27 1941

19

S. J. LEWIS Scout

Map No. 81 Sec. 13 Twp. 20 R. 16W **KANSAS**

Well No. 1 Smith "A"

Stanolind etal Company

Contractor

COMPLETED

SECTION PLAT


C W L SW SE

 Ft. from N. Line

660 Ft. from S. Line

 Ft. from E. Line

330 Ft. from W. Line

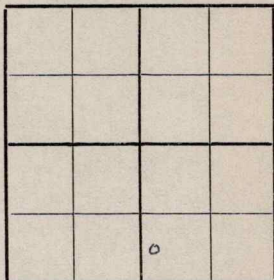

PAWNEE ROCK POOL

Location

Rig up

Drilling and Remarks:

Art 3804

5' 03866

52 shot to 3842-49

12 " 3838-42

2500 acid

Pump 309 BT

382 Gr

RECORD

Cased in., ft.

Sand

Gas

Oil

Total Depth 3867

PRODUCTION

1st 24 hrs. Nat.

1st 24 hrs. after shot

Gas Cu. Ft.

Dry Hole

Abandoned

Date

JUL 30 1941

19

S. J. LEWIS

Scout