


Section 13 Township 25 Range 1E

Well No. 1 Mayall "B"

Company H. C. Bennett

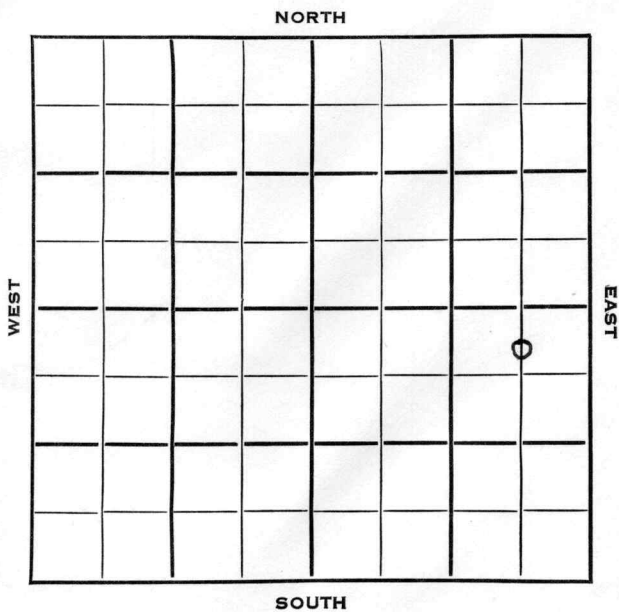

Sedgwick

KANSAS

SEC.	TWP.	R.
13	25	1E ✓

WELL NO.

#1 Mayall "B"

FARM

COMPANY

H.C. Bennett

CONTRACTOR

Salina Drlg.

N. Kuske Pool

330


Ft. from N. Line

Ft. from S. Line

660

Ft. from E. Line

Ft. from W. Line

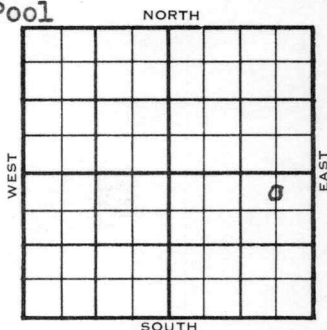

C N L NE SE

ELEVATION

REPORT

1953

11429'

12/30

R U R


1954

2/17

Spud 12-28-53 D & A TD 3030
 8" @ 158 Lans. 2042 KC 2532
 B KC 2720 Burgess 3020 TD 3023
 5" @ 3020 DD 3030' wtr. PB 3022
 Perf/ 3020 HFW
 D & A

ABANDONED

County **Sedgwick** State **Kansas**
 Sec. **13** (Blk.) **25** (Sur.) **1E** Map No.
 (Twp.) (Rge.)
 Operator **H. C. Bennett**
 Well No. **1** Farm **Mayall "B"**
 Elev. Location **C N L NE SE**

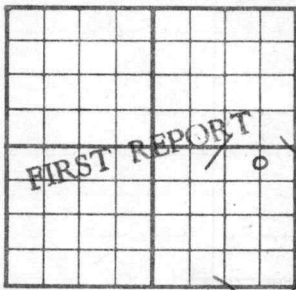

330 Ft. From **N** Line **SE**
660 Ft. From **E** Line Quarter

1st. Report **DEC 30 1953**

Completion

Remarks

Salina Drlg. - Contr.


Spudding Date

Drlg. Data

N. Kuske Pool

R U R

J. G. McGEHEE

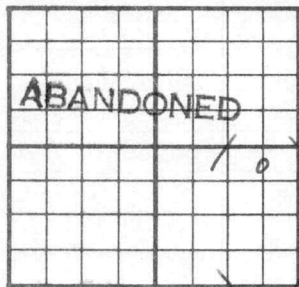County Sedgwick State KansasSec. 13 (Blk.) 25 (Sur.) 1E Map No.Operator H. C. BennettWell No. 1 Farm Mayall "B"Elev. 1429 Location C N L NE SE330 Ft. From N Line SE660 Ft. From E Line Quarter

1st. Report

Completion FEB 17 1954Remarks N. Kuske PoolSalina Drlg. - Contr.Spudding Date 12-28-53Drlg. Data D & A TD 30308" @ 158 Lans. 2042 KC 2532B KC 2720 Burgess 3020 TD 30235" @ 3020 DD 3030 wtr. PB 3022perf/ 3020 HFWD & A

J. G. McGEHEE