

Sedgwick


DX 78-1

KANSAS

Section 13 Township 25 Range 1E

Well No. #3 Schuessler

Company Chas. Carlock

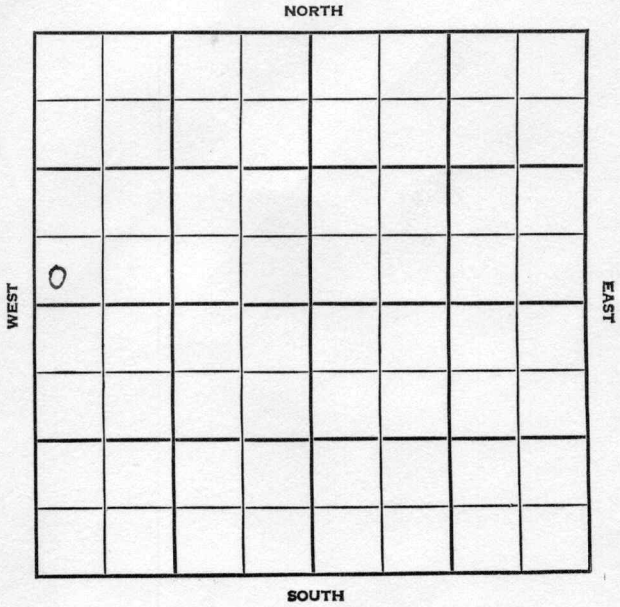

SEC.	TWP.	R.
13	25	1E

WELL NO.

#3 Schuessler

FARM

COMPANY

Chas. Carlock

CONTRACTOR

Morrison Tools.

Kuske Pool

_____ Ft. from N. Line


330

_____ Ft. from S. Line

_____ Ft. from E. Line

330

_____ Ft. from W. Line

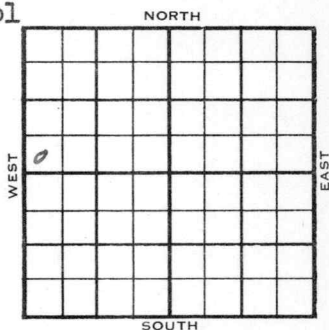

SW SW NW

	ELEVATION	REPORT
1954	1451'	

9/22

C & P

12/8

TD 3024' - Oil Well

8-5/8" @ 114'

TD 2879'

Skid 20' East

Spud 10-8-54

8" @ 126'

KC 2544', Burg 3008'

TD 3011'

5" @ 3010'

DD 3024'

S/35 bopd

Hydro.

S/30 to 40 bfph 25% wtr.

P/100 bopd

Comp. 78 bopd 40% wtr.

COMPLETED

