


Section 32 Township 20 Range 13WWell No. 1 HartmanCompany Ben Brack

Hiss Pool

NORTH

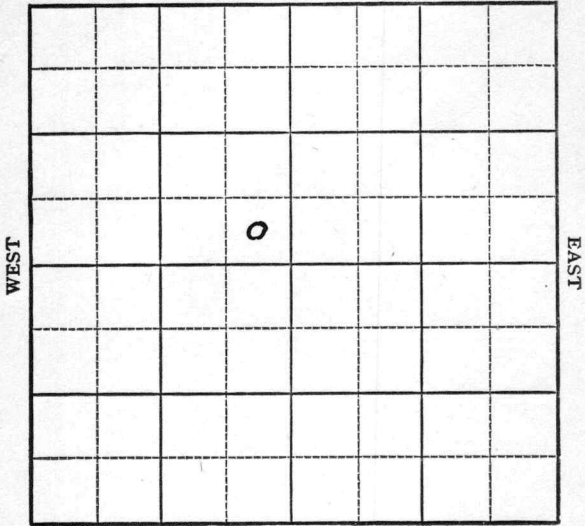

SOUTH

KANSAS

Barton

Sec. 32 Twp. 20 R. 13W ✓

Well No. #1 Hartman Farm

Ben Brack Company

Hiss Pool


Ft. from N. Line

330' Ft. from S. Line

330' Ft. from E. Line

Ft. from W. Line

SE NW

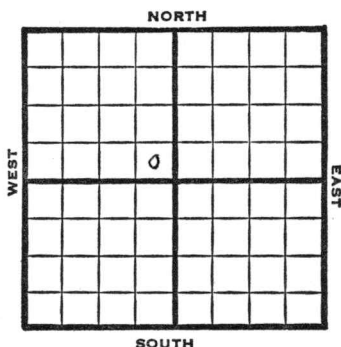

1949	Elev 1897'	REPORT
1/19	8" @ 145'	
	Drlg. 1700'	
1/26	Lansing 3295'	
	Drlg 3472'	
2/2	A buckle 3600'	
	TD 3603'	
	5" @ 3600'	
2/9	24 shots 3467-73	
	500 acid swb 2 oil PH	
	Gravity 16	
	PB 3450'	
2/16	"	
2/23	SD	
3/2	"	
3/8	"	
3/16	"	
3/23	"	
3/30	3000 Butane	
4/6	TD 3689'	
	Arb. 3600'	
	5"@ 3600'	
	Aband.	
	ABANDONED	

Map No. _____ Sec. 32 Twp. _____ R. _____


Well No. 1 Hartman _____

Ben Brack _____ Company

FIRST REPORT _____ Contractor

SE NW

SECTION PLAT

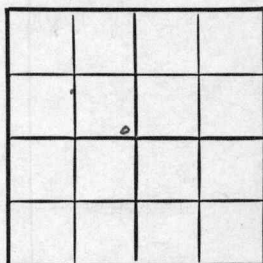

_____ Ft. from N. Line

330 _____ Ft. from S. Line

330 _____ Ft. from E. Line

_____ Ft. from W. Line

Barton County

RECORD

Location _____

Cased _____ in., _____ ft.

Rig up _____

Sand _____

Drilling and Remarks:

Gas _____

Oil _____

Total Depth _____

8" @ 145

PRODUCTION

drlg. 1700

1st 24 hrs. Nat. _____

1st 24 hrs. after shot _____

Gas _____ Cu. Ft.

Dry Hole _____

Abandoned _____

Date

JAN 19 1949

19

S. J. LEWIS

Scout

Kansas

Map No. 82 Sec. 32 Twp. 20 R. 13WWell No. 1 Hartman

Ben Brack


Company

ABANDONED

Contractor

SE NW

SECTION PLAT

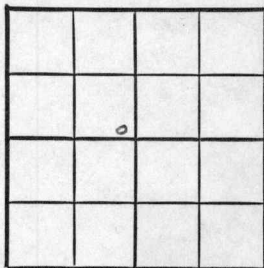

Ft. from N. Line

330 Ft. from S. Line330 Ft. from E. Line

Ft. from W. Line

Barton County

Location

Rig up

Drilling and Remarks:

Art 86005" @ 3600

RECORD

Cased _____ in., _____ ft.

Sand _____

Gas _____

Oil _____

Total Depth 3619

PRODUCTION

1st 24 hrs. Nat. _____

1st 24 hrs. after shot _____

Gas _____ Cu. Ft.

Dry Hole _____

Abandoned _____

Date

APR 6 1949 19

S. J. LEWIS

Scout