

KANSAS

Barton

Section 32 Township 20 Range 13W

Well No. 2 Hartman

Company Ben Brack

Hiss

NORTH

WEST

	0						

EAST

SOUTH

Sec. 32 Twp. 20 R. 13W ✓

Well No. #2 Hartman Farm

Ben Brack Company

Hiss Pool (Brack, Cont.) NORTH

 Ft. from N. Line


330'

 Ft. from S. Line

 Ft. from E. Line

990' Ft. from W. Line

SE SW NW

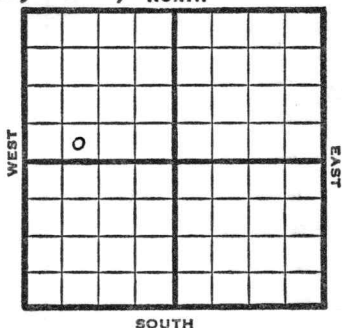

1949

Elev 1904'

REPORT

9/21

RUR

9/28

"

10/5

8"@ 335'

Lansing 3296'

Arb. 3536-40'

TD 3540'

5"@ 3538'

10/12

TD 3562'

500 acid

10/19

Swb 6 bbls oil PH

10/26

"

11/1

"

11/9

"

11/16

TD 3562'

Arb. 3536'

5"@ 3538'

500 acid

Pump 1500 (oil) Pot

40° Gr.

Comp

COMPLETED

Map No. _____ Sec. 32 Twp. 20 R. 13W

Well No. 2 Hartman

Ben Brack Company

Brack Contractor

SE SW NW


FIRST REPORT
SECTION PLAT

_____ Ft. from N. Line

330 Ft. from S. Line

_____ Ft. from E. Line

990 Ft. from W. Line

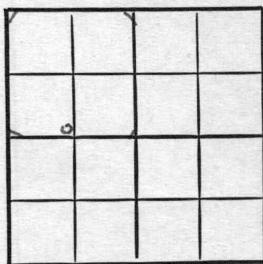

Barton County

Location _____

Rig up _____

Drilling and Remarks:

R U R

RECORD

Cased _____ in., _____ ft.

Sand _____

Gas _____

Oil _____

Total Depth _____

PRODUCTION

1st 24 hrs. Nat. _____

1st 24 hrs. after shot _____

Gas _____ Cu. Ft.

Dry Hole _____

Abandoned _____

Date

SEP 21 1949

19

S. J. LEWIS

Scout

Kansas

Map No. _____ Sec. 32 Twp. 20 R. 13WWell No. 2 Hartman

Ben Brack _____ Company

COMPLETE

Contractor

SE SW NW

E. 1904.
SECTION PLAT

_____ Ft. from N. Line


330

_____ Ft. from S. Line

_____ Ft. from E. Line

990

_____ Ft. from W. Line

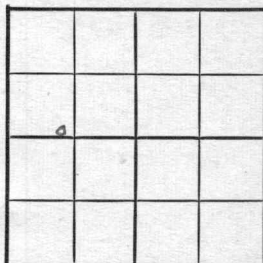

Barton County

Location _____

Rig up _____

Drilling and Remarks:

*Cor 3586**5" Cor 3538**500000**Prod 150 oil 1st**43 - 1st***RECORD**

Cased _____ in., _____ ft.

Sand _____

Gas _____

Oil _____

Total Depth 9582**PRODUCTION**

1st 24 hrs. Nat. _____

1st 24 hrs. after shot _____

Gas _____ Cu. Ft.

Dry Hole _____

Abandoned _____

Date

NOV 16 1949

19

S. J. LEWIS

Scout