


Section 13 Township 25 Range 1E
Well No. #2 Stegg (*Stegg*)
Company Chas. Gould

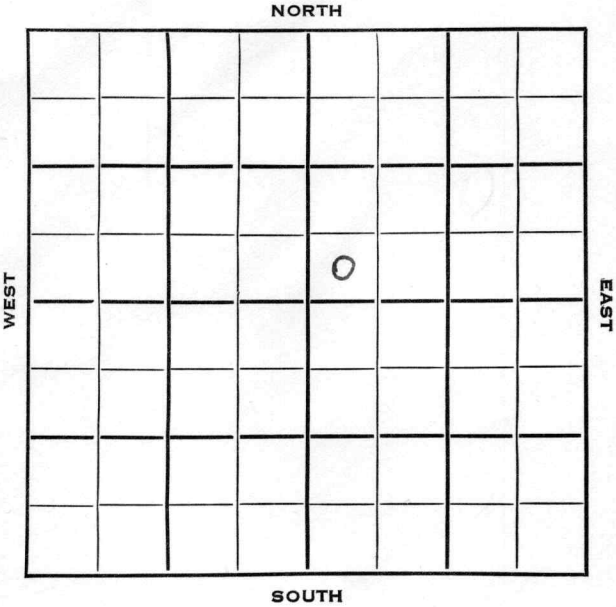


Sedgwick

KANSAS ✓

Sec. 13 Twp. 25 R. 1EWell No. #2 Stegg FarmChas Gould CompanyN. Kuske Pool Contractor Ft. from N. Line330 Ft. from S. Line Ft. from E. Line330 Ft. from W. Line

SW SW NE

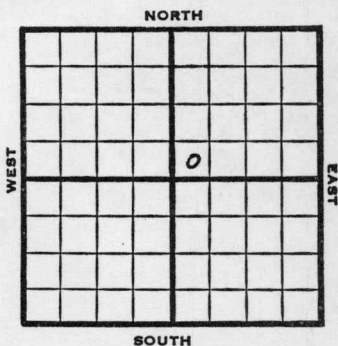1953 Elev. 1442' REPORT

7/22 Spud 7-18-53

8" @ 95'

Drlg 1044'

8/26 Spud 7-18-53

Oil Well

TD 3014

8" @ 95'

KC 2538, BKC 2732, Burgess 3008

TD 3009,

DD 3014

S/2½ boph

Comp. 25 bopd

COMPLETED

J. G. McGEHEE

County Sedgwick State KansasSec. 13 (Blk.
Twp.) 25 (Sur.
Rge.) 1E Map No.Operator Chas. GouldWell No. 2 Farm SteggElev. 1442 Location SW SW NE

330 Ft. From S Line NE330 Ft. From W Line Quarter

1st. Report

Completion AUG 26 1953Remarks N. Kuske PoolSpudding Date 7-18-53Drig. Data Oil well TD 30148" @ 95 B KC 2538 B KC 2732Burgess 3008 TD 3009 DD 3014S/ 2 $\frac{1}{2}$ boph Comp. 25 bopd

J. G. McGEHEE