


Section 32 Township 20 Range 13WWell No. #3 HartmanCompany Ben Brack Oil

NORTH

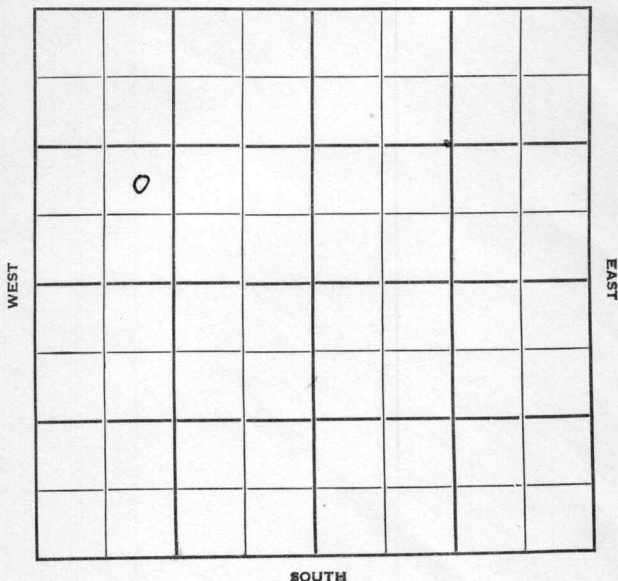

KANSAS

Barton

32

20

13-W

Sec. _____ Twp. _____ R. _____

Well No. **#3 Hartman** Farm

Ben Brack Oil Company

Ben Brack Contractor

SE Hiss


_____ Ft. from N. Line

990 _____ Ft. from S. Line

_____ Ft. from E. Line

990 _____ Ft. from W. Line

NE SW NW

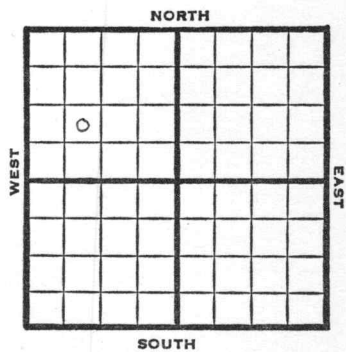

1950 Elev 1899' REPORT

10/4	Spud 9-28-50 8 5/8" @ 330 Anhy 780 drlg 1820	
11/15	8 5/8" @ 330 Anhy 780 Marmaton 3513 5" @ 3528 TD 3540 FU 500' oil 12 hr 1000 A DD 3544 FU 1200' oil 12 hr 1000 A Comp 118 bopd 16% water Completed TD 3544'	Lans 3284 Arb 3527

COMPLETED

County Barton State KansasSec. 32 (Blk. Twp.) 20 (Sur. Rge.) 13W Map No.Operator Ben Brack OilWell No. 3 Farm HartmanElev. Location NE SW NW

	0						

FIRST REPORT

990 Ft. From S Line NW990 Ft. From W Line Quarter1st. Report OCT 4 1950

Completion

Remarks

Ben Brack - Contr.Spudding Date 9-28-50Drlg. Data SE Hiss Pool8 5/8" @ 330 Anhy 780 drlg. 1820

Sec.	32	(Blk. Twp.)	20	(Sur. Rge.)	13W	Map No.
------	----	----------------	----	----------------	-----	---------

Well No. 3 Farm Hartman

Elev.	1899	Location	NE SW NW
-------	------	----------	----------

990 Ft. From S Line NW

990 Ft. From W Line Quarter

1st. Report

Completion NOV 15 '950

Remarks SE Hiss Pool

Ben Brack - Contr.

Spudding Date 9-28-50

Drlg. Data Oil well TD 3544

8 5/8" @ 330 Anhy 780 Lams. 3284

Marmaton 3513 Arb. 3527 5" @ 3528

TD 3540 FU 500' oil 12 hr. 1000 A

DD 3544 FU 1200' oil 12 hr. 1000 A

Comp. 118 bopd 16% water

J. E. TYRA