
FORM 51

Sedgwick KANSAS

Section 13 Township 25 Range 1E

Well No. #3 Steeg

Company Bennett & Gould

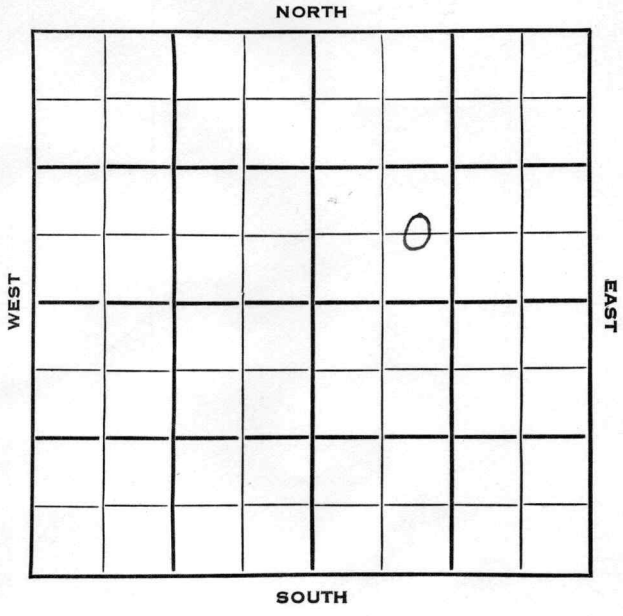

Sedgwick

KANSAS

SEC.	TWP.	R.
13	25	1E

WELL NO.

#3 Steeg FARM

COMPANY

Bennett & Gould

CONTRACTOR

Salina Drlg.


N. Kuske Pool

_____ Ft. from N. Line

660 Ft. from S. Line

_____ Ft. from E. Line

990 Ft. from W. Line

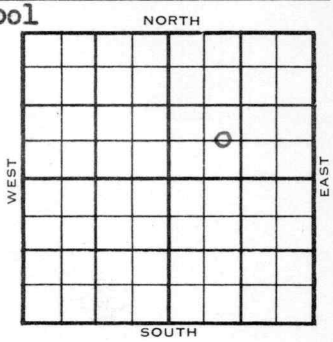

C E L SW NE

	ELEVATION 1436' REPORT
1953	
9/30	R U R
10/28	Spud 9-28-53 Oil well TD 3020' 8" @ 104 KC 2530 Burgess 2995 TD 3004 5" @ 3003 DD 3006 7 BO 2 BW 24 hrs. DD 3020 HFW PB 3011 sd-frac. Comp. 25 BOPD COMPLETED

DX-78

FORM 275 FOR SALE BY KANSAS BLUE PRINT CO.


County Sedgwick State Kansas

Sec. 13 (Blk. Twp.) 25 (Sur. Rge.) 1E Map No.

Operator Bennett & Gould

Well No. 3 Farm Steeg

Elev. Location C E L SW NE

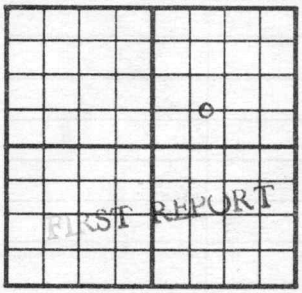

660 Ft. From S Line NE

990 Ft. From W Line Quarter

1st. Report SEP 30 1953

Completion

Remarks Salina Drlg. - Contr.

Spudding Date N. Kuske Pool

Drlg. Data

R U R

J. G. McGEHEE

FORM 275 FOR SALE BY KANSAS BLUE PRINT CO.


County Sedgwick State Kansas

Sec. 13 (Blk. Twp.) 25 (Sur. Rge.) 1E Map No.

Operator Bennett & Gould

Well No. 3 Farm Steeg

Elev. 1436 Location C E L SW NE

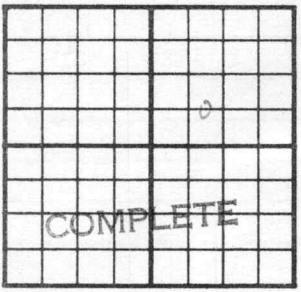

660 Ft. From S Line NE

990 Ft. From W Line Quarter

1st. Report

Completion OCT 28 1953

Remarks N. Kuske Pool
Salina Drlg. - Contr.

Spudding Date 9-28-53

Drlg. Data Oil well TD 3020

8" @ 104 KC 2530 Burgess 2995

TD 3004 5" @ 3003 DD 3006 7 bo

2 bw 24 hr. DD 3020 HFW PB 3011

sd-frac Comp. 25 bopd

J. G. McGEHEE