

Section 13 Township 25 Range 1 E

Well No. # 1 Vandever

Company Francis Raymond

NORTH

|  |  |  |   |  |  |  |  |
|--|--|--|---|--|--|--|--|
|  |  |  |   |  |  |  |  |
|  |  |  |   |  |  |  |  |
|  |  |  |   |  |  |  |  |
|  |  |  |   |  |  |  |  |
|  |  |  | 0 |  |  |  |  |
|  |  |  |   |  |  |  |  |
|  |  |  |   |  |  |  |  |
|  |  |  |   |  |  |  |  |

WEST

EAST

SOUTH

Sec. 13 Twp. 25 R. 1E

Well No. #1 Vandever Farm

Francis Raymond Company

Salina Drlg. Contractor

NE Kuske Pool


330 Ft. from N. Line

\_\_\_\_\_ Ft. from S. Line

330 Ft. from E. Line

\_\_\_\_\_ Ft. from W. Line

NE NE SW

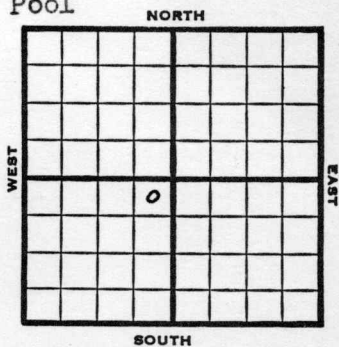

1953 Elev. 1450'

REPORT

6/17 Spud 6-8-53  
KC 2553'

7/1 Spud 6-8-53  
Oil Well  
TD 3026  
KC 2553, B KC 2742,  
DST 2636-40, opn 1 $\frac{1}{4}$  hrs., rec. 7' mud  
75#  
1st Sd 3014, Burgess 3020  
TD 3023  
5" @ 3022  
DD 3026  
Comp. 25 bopd



County Sedgwick State Kansas

Sec. 13 (Blk. 25) (Sur. Rge.) 1E Map No.

Operator Francis Raymond

Well No. 1 Farm Vandever

Elev. 1450 Location NE NE SW

|  |  |  |  |  |  |
|--|--|--|--|--|--|
|  |  |  |  |  |  |
|  |  |  |  |  |  |
COMPLETE

o

330Ft. From N Line SW

330Ft. From E Line Quarter

1st. Report

Completion JUL 1 1953

Remarks NE Kuske Pool

Salina Drlg. - Contr.

Spudding Date 6-8-53

Drlg. Data Oil well TD 3026

KC 2553 B KC 2742 DST 2636-40

open 1 1/4 hr. Rec. 7' mud 75# 1st sd.

3014 Burgess 3020 TD 3023 5" @ 3022

DD 3026 Comp. 25 bopd