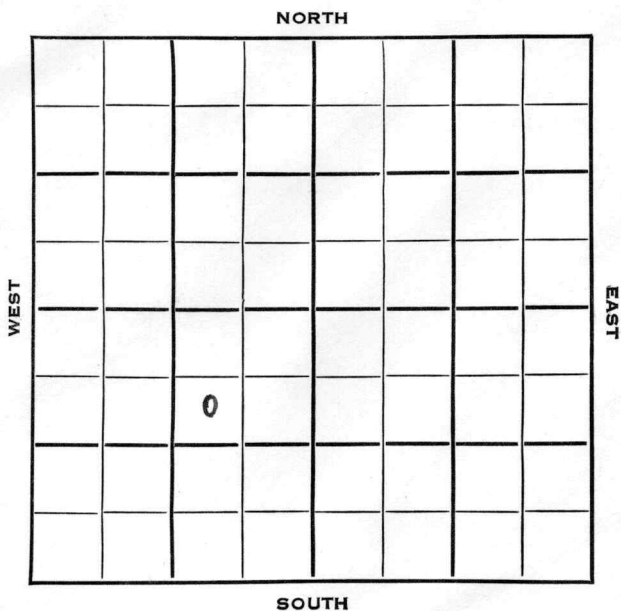


Section 13 Township 25 Range 1 EWell No. # 2 VandeverCompany Francis Raymond

Sedgwick

KANSAS

SEC.	TWP.	R.
13	25	1E

WELL NO.

#2 Vandever

FARM

COMPANY

Francis Raymond

CONTRACTOR

Saturn Drlg.

990

Ft. from N. Line


Ft. from S. Line

990

Ft. from E. Line

Ft. from W. Line

SW NE SW

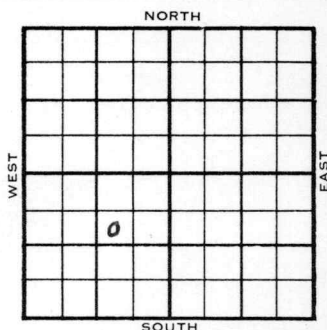

1953

ELEVATION

1448'

REPORT

9/9

M I R

10/7

Spud 9-8-53

Oil Well

TD 3035'

8" @ 166'

Burgess 3029,

TD 3030'

5" @ 3030'

CO to 3030 DD 3035

SO & W frac.

Comp 25 bopd 30% wtr.

COMPLETED

J. G. McGEHEE