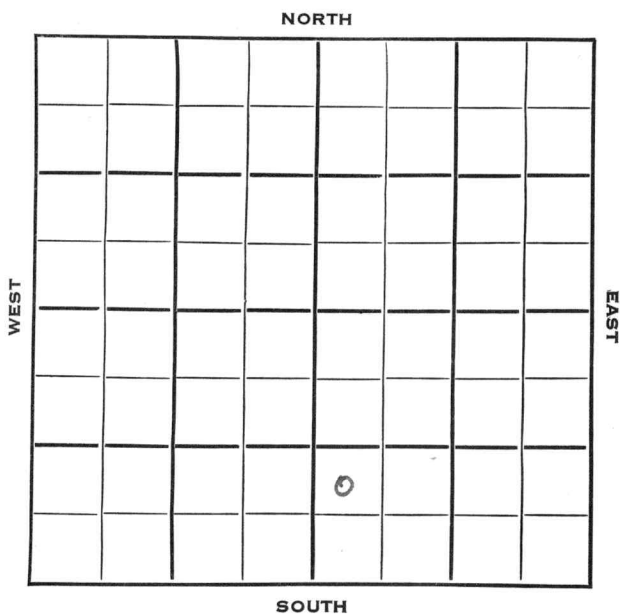


Section 32 Township 20 Range 13WWell No. 1 HissCompany Don Jones et al

Barton KANSAS

SEC.	TWP.	R.
32	20	13W ✓

WELL NO.

1 Hiss

FARM

COMPANY

Don Jones et al

CONTRACTOR

Fleming & Woodman


SE Hiss Pool

_____ Ft. from N. Line

990 _____ Ft. from S. Line

_____ Ft. from E. Line

330 _____ Ft. from W. Line

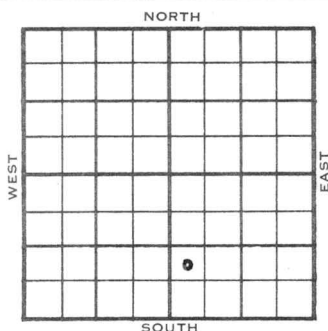

NW SW SE

1954	ELEVATION 1896'	REPORT
------	--------------------	--------

- 2/17 Spud 2-13-54
8" @ 273'
Anhy 780'
Drlg. 1910'
- 2/24 Heeb 3180', Br li 3297', Lans 3308'
Drlg. 3546'
- 3/3 Spud 2-13-54
D &A
TD 3623'
8" @ 273'
Anhy 780', Heeb 3180', Br. Lime 3297'
Lans 3308', Arb 3586',
DST 3587'-95' opn $\frac{1}{4}$ hr, rec 12' Mud
390#
TD 3623'
D &A

ABANDONED

County Barton State KansasSec. 32 (Blk.) 20 (Sur.) 13W Map No.Operator Don Jones etal.Well No. 1 Farm HissElev. Location NW SW SE

FIRST REPORT

990 Ft. From S Line SE330 Ft. From W Line Quarter1st. Report FEB 17 1954

Completion

Remarks

Fleming & Woodman - Contr.Spudding Date 2-13-54Drlg. Data SE Hiss Pool8" @ 273 Any 780 drlg. 1910

County Barton State Kansas
 Sec. 32 (Blk.) 20 (Sur.) 13W Map No.
 Operator Don Jones et al.
 Well No. 1 Farm Hiss
 Elev. 1896 Location NW SW SE



990 Ft. From S Line SE
330 Ft. From W Line Quarter

1st. Report

Completion MAR 3 1954

Remarks SE Hiss Pool

Fleming & Woodman - Contr.

Spudding Date 2-13-54

Drlg. Data D & A TD 3623

8" @ 273 Anhy 780 Heeb. 3180

Br. lime 3297 Lans. 3308 Arb. 3586

DST 3587-95 open $\frac{1}{4}$ hr. Rec. 12' mud

390# TD 3623

D & A

J. G. McGEHEE