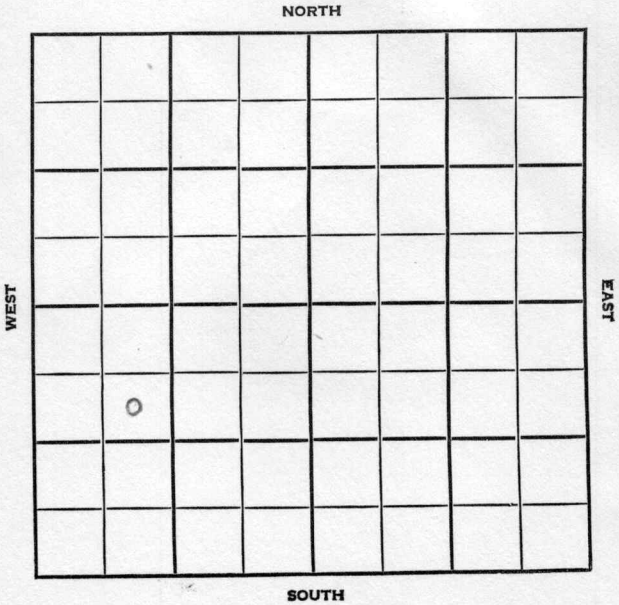


Section 13 Township 25 S Range 1 EWell No. #3 VandaveerCompany Francis Raymond

Sedgwick

KANSAS

SEC.

TWP.

R.

13

25S

1E

WELL NO.

#3 Vandaveer

FARM

COMPANY

Francis Raymond

CONTRACTOR

~~Murfin~~ Murfin

Kuske

Ft. from N. Line


Ft. from S. Line

Ft. from E. Line

Ft. from W. Line

SE NW SW

NORTH

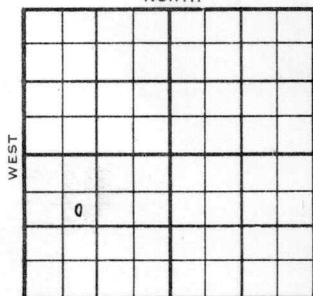

ELEVATION

REPORT

1955

1453 DF

9-28- Comm. June or July 1954

TD 3024

5" @ 3024;

CO DD 3027; fill 300' f 14 hrs.;

DD 3030; test 1 boph 1 hr.

DD 3035 TD; test 11 boph 3 hrs. ;

pmp 153 bopd w/trc. nat.

OH 3024-35;

Tops:L. 2324

KC 2550

BKC 2745

Burgess 3023

TD 3035

FIRST REPORT

d

COMPLETED

County Sedwick Elev. 1453 DF
 Sec. 13 Twp. 25S Rge. 1E
 Company Francis Raymond
 Farm Name Vandaveer No. 3

TOPS	DEPTH	LOG	DATUM	Loc. in Sec.
Anh.				SE NW SW
Tp.				
H.				
Tr.				
Dg.				
Bl.				
L.	2324			Geol.
K.C.	2550			Contr.
B.K.C.	2745			Murfin
Gurgess	3023			Pool
C.				Kuske
M.				
M.				
K.				
Mz.				
Mq.				
V.				
S.				
S.				
A.				FIRST REPORT
R.				
Pf.				
G.				
T.D.	3035			COMPLETED

Date Comm. June or July 1954

SEP 28 1955

TD 3024; 5" 3024; CO DD 3027; fill 300' f
 14 hrs.; DD 3030; test 1 boph 1 hr.;
 DD 3035 TD; test 11 boph 3 hrs.; pmp 153
 bopd w/trc. nat. OH 3024-35; TD 3035

COMPLETE