

KANSAS

Barton

Section 32 Township 20 Range 13W

Well No. 2 Wright

Company Ben Brack

Hiss
NORTH

WEST

EAST

SOUTH

0

KANSAS

Barton



Sec. 32 Twp. 20 R. 13W

Well No. #2 Wright Farm

Ben Brack Company

Hiss Pool


990' Ft. from N. Line

_____ Ft. from S. Line

330' Ft. from E. Line

_____ Ft. from W. Line

SE NE SW

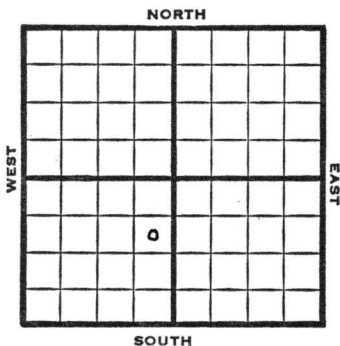

1949

Elev 1898'

REPORT

2/23

Location

3/2

8" @ 142'

Drlg. 1900'

3/8

Drlg 3316'

3/16

Lansing 3302

Arb. 3553-56'

TD 3556'

5" @ 3552'

3/23

TD 3558'

Arb. 3553'

5" @ 3552

Pump 176 Oil Pot

36° Gr.

Comp

COMPLETED

Kansas

Map No. 82 Sec. 32 Twp. 20 R. 13W

Well No. 2 Wright

Ben Brack Company

COMPLETE

Contractor

SE NE SW

E. H. 1897
SECTION PLAT

990 Ft. from N. Line

_____ Ft. from S. Line

330 Ft. from E. Line

_____ Ft. from W. Line

Barton County

RECORD

Location _____

Cased _____ in., _____ ft.

Rig up _____

Sand _____

Drilling and Remarks:

Gas _____

Oil _____

Total Depth 3035

CR 8055
5" 63552
Pump 176 oil Pt

86 3/4

PRODUCTION

1st 24 hrs. Nat. _____

1st 24 hrs. after shot _____

Gas _____ Cu. Ft.

Dry Hole _____

Abandoned _____

Date

MAR 23 1949 19

S. J. LEWIS Scout

Map No. _____ Sec. 32 Twp. 20 R. 13W

Well No. 2 Wright

Ben Black Company

FIRST REPORT Contractor

SE NE SW

SECTION PLAT

990 Ft. from N. Line

_____ Ft. from S. Line

330 Ft. from E. Line

_____ Ft. from W. Line

Barton County

Location X

Rig up _____

Drilling and Remarks:

RECORD

Cased _____ in., _____ ft.

Sand _____

Gas _____

Oil _____

Total Depth _____

PRODUCTION

1st 24 hrs. Nat. _____

1st 24 hrs. after shot _____

Gas _____ Cu. Ft.

Dry Hole _____

Abandoned _____

Date

FEB 23 1949 19

S. J. LEWIS Scout