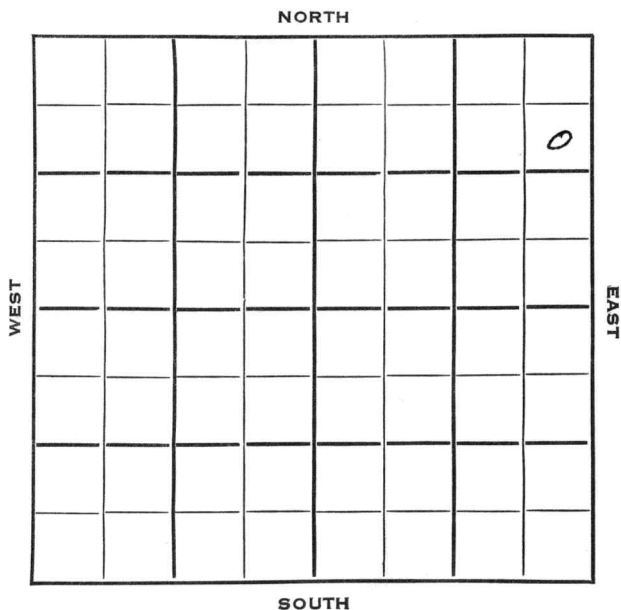


Section 32 Township 20 Range 13WWell No. #2 Hartman Est.Company Magnolia Petroleum Corporation

Barton

KANSAS

Sec. 32 Twp. 20 R. 13WWell No. #2 Hartman Est. FarmMagnolia Petroleum Company Company

Contractor

E. Hiss Pool


720 Ft. from N. Line

Ft. from S. Line

330 Ft. from E. Line

Ft. from W. Line

SE NE NE

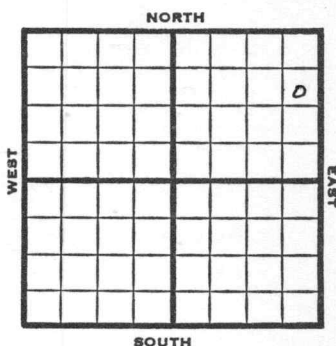

1953 Elev. 1896' REPORT

3/4 MIM

3/12 8" @ 320

Drlg. 1770'

3/19 Heeb 3155, Lans 3282
 DST 3415-34, 1 hr., 360' gas,
 3' HO&GCM, 58' SO&GCM
 DST 3434-58, 1½ hrs., 20' M
 Arb. 3557

RTD 3560 Schl

3/26 5" @ 3558 CO DD 3565 SSO
 DD 3572 1000 A

4/2 Testing

4/9 "

4/16 "

4/23 "

4/29 Spud 3-6-53

Oil Well

TD 3639'

8" @ 320'

Heeb 3155, Lans 3282,

DST 3415-34 opn 1 hr. rec 360' gas, 3'
 ho & gcm 58' so & gcm

DST 3434-58 opn 1½ hr, rec 20' mud off
 Arb 3557,

OVER

1953

Information brought forward.

4/29 TD 3560'
5" @ 3558'
DD 3565
DD 3572 1000 A DD 3639 B/ $\frac{1}{4}$ bwph
2000 A S/ 15 bo 36 bwph PB 3480
24/ 3469-73 S/ 2 go 2 gwph 4 hr.
2000 A S/ 1 boph 6 hr. PB 3462
36/ 3448-54 3000 A S/ 9 boph 2 hr.
S/ 4 boph 4% wtr. DP 3462 S/ 5 boph
7 hr. 4% sw. PB 3442 24/ 3416-20
B/ 2 goph 4000 A S/ 6 boph DP 3476
S/ 58 bo 4% sw P/ 7 bo 7 hr. P/ 23
bo 24 hr.
Comp. 7 bopd 2 bw.

COMPLETED

County Barton State KansasSec. 32 (Blk. 20 (Sur. 13W (Twp. Rge.) Map No.Operator Magnolia Pet.Well No. 2 Farm Hartman Est.Elev. 1896 Location SE NE NE

720 Ft. From N Line NE330 Ft. From E Line Quarter

1st. Report

Completion APR 29 1953Remarks E. Hiss PoolSpudding Date 3-6-53Drig. Data Oil well TD 3639

8" @ 320 Heeb. 3155 Lans. 3282

DST 3415-34 open 1 hr. Rec. 360' gas

3' ho & gcm 58' so & gcm DST 3434-58

open 1½ hr. Rec. 20' mud O# Arb. 3557

TD 3560 5" @ 3558 DD 3565 DD 3572

1000 A DD 3639 B/ ¼ bwph 2000 A

S/ 15 bo 36 bwph PB 3480 24/ 3469-73

S/ 2 go 2 gwph 4 hr. 2000 A S/ 1 boph

6 hr. PB 3462 36/ 3448-54 3000 A

S/ 9 boph 2 hr. S/ 4 boph 4% sw

DP 3462 S/ 5 boph 7 hr. 4% sw

PB 3442 24/ 3416-20 B/ 2 goph 4000 A

S/ 6 boph DP 3476 S/ 58 bo 4% sw

P/ 7 bo 7 hr. P/ 23 bo 24 hr.

Comp. 7 bopd 2 bw

J. G. McGEHEE

County Barton State Kansas
 Sec. 32 (Blk.) 20 (Sur.) 13W Map No.
 Operator Magnolia Pet.
 Well No. 2 Farm Hartman Est.
 Elev. _____ Location SE NE NE

									0

FIRST REPORT

720 Ft. From N Line NE
330 Ft. From E Line Quarter

1st. Report MAR 4 1953

Completion _____

Remarks _____

Spudding Date _____

Drlg. Data _____

E. Hiss Pool

M I M