

Section 32 Township 20 Range 13WWell No. 2 HissCompany Ohio
Hiss

					0		

NORTH

WEST

EAST

SOUTH

Barton

Sec. 32 **KANSAS** Twp. 20 R. 13W ✓

Well No. #2 Hiss Farm

Ohio

Company

Hiss Pool


330' Ft. from N. Line

_____ Ft. from S. Line

_____ Ft. from E. Line

990' Ft. from W. Line

NE NW SE

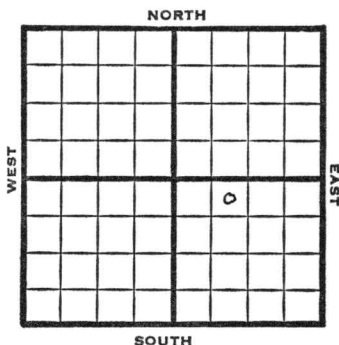

1949

Elev 1894'

REPORT

1/12

Location

1/19

Drlg 235'

1/26

10" @ 224'

Drlg 1415'

2/2

Drlg. 2290'

2/9

Lansing 3298'

Arbuckle 3552'

Drlg. 3564'

2/16

TD 3564'

5" @ 3553'

2/23

Swb 1 oil in 8 hrs.

3/2

Plug 3466'

15 shots 3455-60 wtr

3/9

TD 3564'

Arb. 3552'

5" @ 3553'

Aband.

ABANDONED

Map No. _____ Sec. 32 Twp. 20 R. 13W

Well No. 2 Hiss

Ohio

Company

FIRST REPORT

Contractor

NE NW SE


SECTION PLAT

330 Ft. from N. Line

_____ Ft. from S. Line

_____ Ft. from E. Line

990 Ft. from W. Line

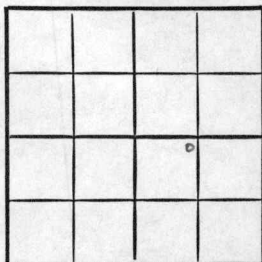

Barton County

RECORD

Location X

Rig up _____

Drilling and Remarks:

Cased _____ in., _____ ft.

Sand _____

Gas _____

Oil _____

Total Depth _____

PRODUCTION

1st 24 hrs. Nat. _____

1st 24 hrs. after shot _____

Gas _____ Cu. Ft.

Dry Hole _____

Abandoned _____

Date

JAN 1 2 1949

19

S. J. LEWIS

Scout

Kansas


Map No. 82 Sec. 32 Twp. 20 R. 13WWell No. 2 HissOhio

Company

ABANDONED

Contractor

NE NW SE

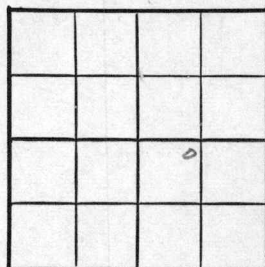E. 1894
SECTION PLAT330 Ft. from N. Line Ft. from S. Line Ft. from E. Line990 Ft. from W. LineBarton CountyLocation Rig up

Drilling and Remarks:

CR 83552
5" CR 83553

RECORD

Cased in., ft.Sand Gas Oil Total Depth 3564

PRODUCTION

1st 24 hrs. Nat. 1st 24 hrs. after shot Gas Cu. Ft.Dry Hole Abandoned

Date

MAR 9 1949

19

S. J. LEWIS

Scout