


Section 14 Township 25 Range 1 E

Well No. # 3 Beecher

Company Francis Raymond

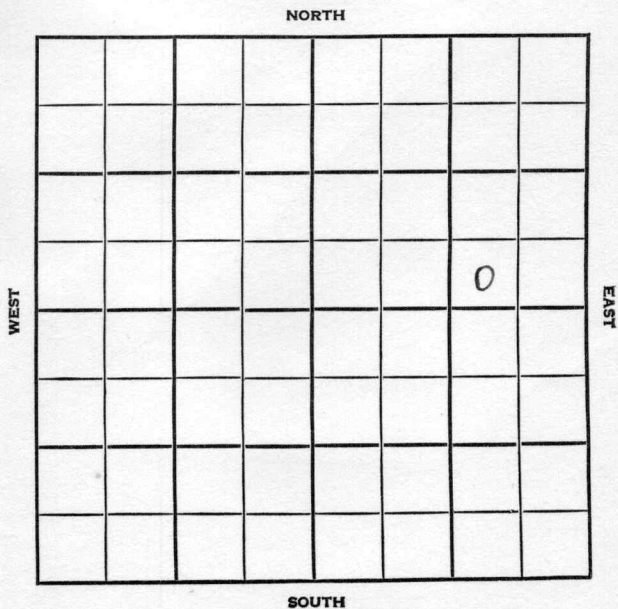

Sedgwick KANSAS

SEC.	TWP.	R.
14	25	1E

WELL NO. 3 Beecher FARM

COMPANY Francis Raymond


CONTRACTOR Murfin Drlg.

_____ Ft. from N. Line

330 _____ Ft. from S. Line

990 _____ Ft. from E. Line

_____ Ft. from W. Line

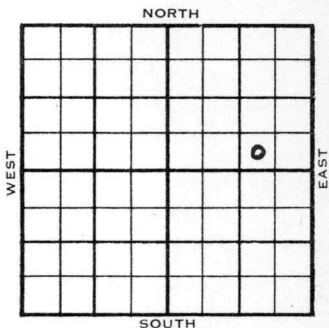

SW SE NE

1954	ELEVATION	REPORT
	1449'	

10/20

Spud 10-14-54
8" @ 186'
Drlg. 2500'

12/8

Spud 10-14-54 - Oil Well
TD 3046'
8" @ 186'
Lans 2332', KC 2553', B KC 2751',
Burg. 3036'
TD 3040'
5" @ 3036'
DD 3046'
FU 540' fluid 12 hrs. ~~13%~~ 7% oil
PB 3039'
9/3036-39,
A-frac
S/3½ bo 1½ bwph
P/5 bfph 30% wtr.
Comp. 29 bōpd 66% wtr.

COMPLETED

County **Sedgwick** State **Kansas**

Sec. **14** (Blk. **25**) (Sur. **1E**) (Twp.) (Rge.) Map No.

Operator **Francis Raymond**

Well No. **3** Farm **Beecher**

Elev. **1449** Location **SW SE NE**

330 Ft. From **S** Line **NE**

990 Ft. From **E** Line **Quarter**

Ist. Report

Completion **DEC 8 1954**

Remarks **Murfin Drlg. - Contr.**

Spudding Date **10-14-54**

Drlg. Data **Oil well TD 3046**

8" @ 186 Lans. 2332 KC 2553

B KC 2751 Burg. 3036 TD 3040

5" @ 3036 DD 3046 FU 540' fluid 12 hr.

7% oil PB 3039 9/ 3036-39

A-frac S/ 3½ bo 1½ bwph P/ 5 bfph

30% wtr. Comp. 29 bopd 66% wtr.