

Sedgwick

Form 51-5M-2-29-34703

Map No.

KANSAS

Sec.

15

Twp.

25

R.

1E

Well No.

1-Brown

Farm

Continental Oil


Company

NORTH

WEST

EAST

SOUTH

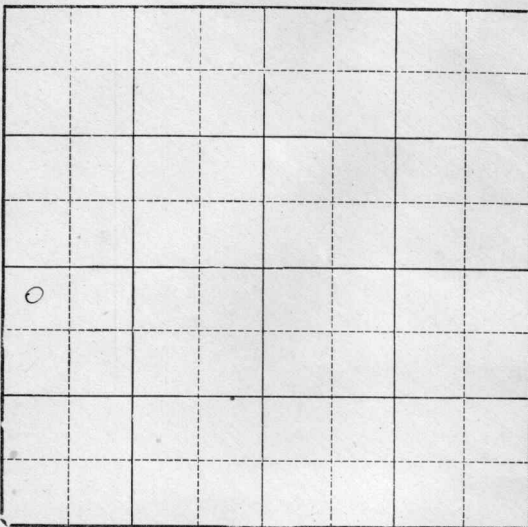

Location

Drilling Remarks

Rig Up

Drilling Remarks

RECORD

Cased in. ft.

Sand

Gas

Oil

Total Depth

PRODUCTION

1st 24 hrs. Nat.

1st 24 hrs. after shot

Gas cu. ft.


Dry Hole

Abandoned

Map No. KANSAS Sec. 15 Twp. 25 R. 1E

Well No. 1- Brown Farm
Continental Oil Company

NORTH

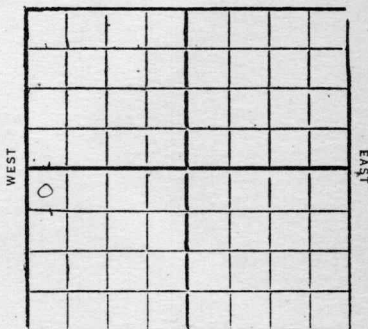

330 Ft. from N. Line

_____ Ft. from S. Line

_____ Ft. from E. Line

330 Ft. from W. Line

1931

Date

REPORT

12/30	ROS
1932	
1/7	Bldg rig
1/13	Break up
1/20	Drldg 360'
1/27	Drldg 895'
2/3	8 1/2" - 1222
	Drldg 1732'
2/10	10" - 1874
	Drldg 2382'
2/17	5 bailers water 2377-85
	8 1/4" - 2595
	drldg 2600'
2/26	Lime 2614-18'
	TD 2618
	swab 142 bbl 1 st 24 hr
	May deepen
3/2	and 2614-2618
	TD 2618'
	Pump 80 bbl oil
	Comp.

13 KANSAS

Map No. Sec. 15 Twp. 25 R. 1

Well No. 1 Brown

Continental Oil Co. Company

Contractor

FIRST REPORTS

330 Ft. from N. Line

Ft. from S. Line

Ft. from E. Line

330 Ft. from W. Line

SECTION PLAT

0			

Location

Rig up R O S

Drilling and Remarks:

RECORD

Cased in., ft.

Sand

Gas

Oil

Total Depth

PRODUCTION

1st 24 hrs. Nat.

1st 24 hrs. after shot

Gas Cu. Ft.

Dry Hole

Abandoned

Date

DEC 30 1931

192

CHAS. L. SHERWOOD

Scout

13 **KANSAS** Sec. 15 Twp. 25 R. 1 E

Well No. 1 Brown

Continental Oil Co Company

Contractor

COMPLETE

SECTION PLAT

0			

230 Ft. from N. Line

Ft. from S. Line

Ft. from E. Line

230 Ft. from W. Line

Location

Rig up

Drilling and Remarks:

Pump 80 hrs.

RECORD

Cased in., ft.

Sand 7614-7618

Gas

Oil

Total Depth 7618

PRODUCTION

1st 24 hrs. Nat.

1st 24 hrs. after shot

Gas Cu. Ft.

Dry Hole

Abandoned

Date

MAR

2 1932

CHAS. L. SHERWOOD

19

Scout