


Barton

KANSAS

Section 32 Township 20 Range 13W

Well No. #1 "A" Wright

Company Ben Brack

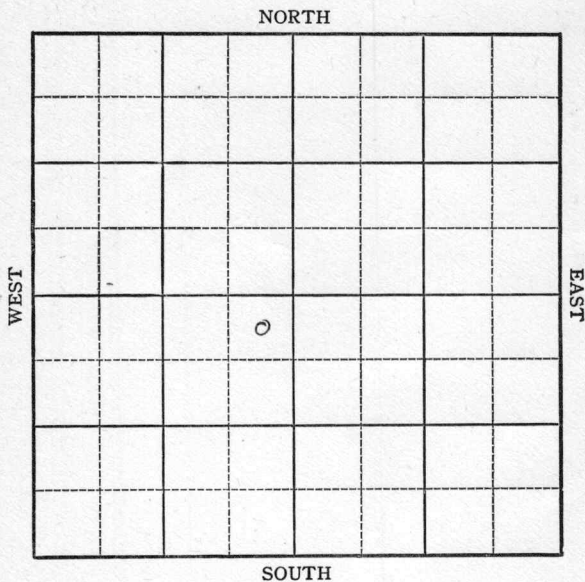

Barton

KANSAS

Sec. 32 Twp. 20 R. 13W

Well No. #1 "A" Wright Farm

Ben Brack

Company

His s Pool

(Brack, Contr.)


330' Ft. from N. Line

 Ft. from S. Line

250' Ft. from E. Line

 Ft. from W. Line

NE SW Twin Well

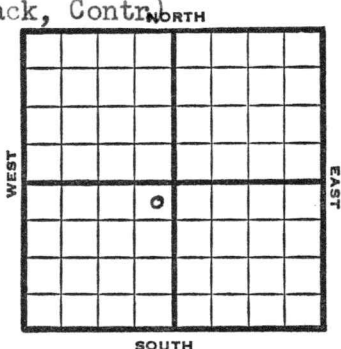

1949

Elev 1898'

R E P O R T

11/23

8" @ 328'

Drlg. 496'

11/29

Drlg 3175'

12/7

Lansing 3298'

Arb. 3466-81'

TD 3481'

5" @ 3480'

12/14

"

12/21

Drlg cement

12/28

"

1950

2/1

TD 3580'

8" @ 328'

5" @ 3580'

Lans 3298'

Arb. 3566'

D&A

Aband.

ABANDONED

Map No. _____ Sec. 32 Twp. 20 R. 13WWell No. 1 "A" Wright

_____ Ben Brack _____ Company

_____ Brack _____ Contractor


NE SW

FIRST REPORT
SECTION PLAT330 Ft. from N. Line

_____ Ft. from S. Line

250 Ft. from E. Line

_____ Ft. from W. Line

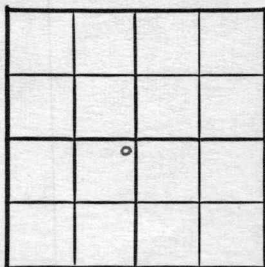

Barton County

Location _____

Rig up _____

Drilling and Remarks:

8" @ 328

drlg. 496

twin well

RECORD

Cased _____ in., _____ ft.

Sand _____

Gas _____

Oil _____

Total Depth _____

PRODUCTION

1st 24 hrs. Nat. _____

1st 24 hrs. after shot _____

Gas _____ Cu. Ft.

Dry Hole _____

Abandoned _____

Date

NOV 23 1949

19

S. J. LEWIS

Scout

Kansas

Hiss Pool

Map No. _____ Sec. 32 Twp. 20 R. 13WWell No. 1-A WrightBen Brack

Company

Contractor

NE SW

E1. 1898

SECTION PLAT


330 Ft. from N. Line

Ft. from S. Line

250 Ft. from E. Line

Ft. from W. Line

Barton County

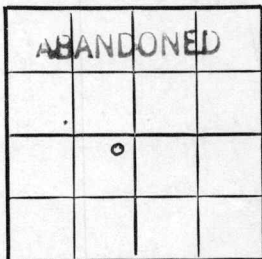

Location _____

Rig up _____

Drilling and Remarks:

8" @ 328

5" @ 3580

Lans 3298

Anb 3566

D & A

RECORD

Cased _____ in., _____ ft.

Sand _____

Gas _____

Oil _____

Total Depth 3580

PRODUCTION

1st 24 hrs. Nat. _____

1st 24 hrs. after shot _____

Gas _____ Cu. Ft.

Dry Hole _____

Abandoned _____

Date

FEB 1 1950

J. E. TYRA

19

Scout