

Sedgwick

Map No. KANSAS Sec. 16 Twp. 25 R. 1E

Well No. 1-Black Farm


~~Marland Oil~~ Company
Continental Oil Co NORTH

_____ Ft. from N. Line

330 Ft. from S. Line

990 Ft. from E. Line

_____ Ft. from W. Line

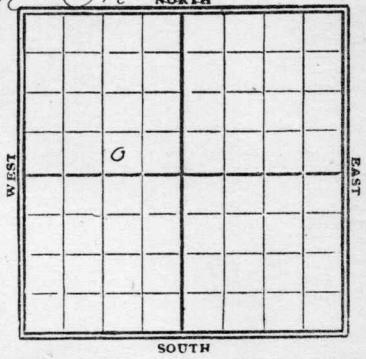

1929

Date	REPORT
5/1	Rig
5/8	Rigging up
5/15	well 400'
5/22	" 1360'
5/29	" 1875
6/5	" 1985
6/12	" 2535
6/19	well 2892 top KC 2590 show oil
6/26	well 2935'
7/2	Chat 2977 show oil at 2980-84 Pay 3009'-12 TD swabbed 240 bbls
7/9	Chat 2977' show oil 2980-84' Pay - 3009-12' T.D. 3012' Pump 200 bbl oil Sump
1931	OWIDD
9/29	Old TD. 3012 Rgn up

8/5- drlg 3018'

8/12- " 3140'

8/19- " 3255'

8/26- Base line 3260
drlg 3303

9/2- Top Viola 3334
700' oil & water
TD. 3337 S/R 6"

9/9- TD. 3337
S/R 6" to 3325

9/16- TD. 3337
Dem 6"-3315'

9/23- TD. 3337
swab 245 bbl 1st 24 hr
and 257 " 2nd 24"
show water

Pump 205 bbl 1st 12 hr
6"-3325

9/30- Viola 3334-37
TD. 3337

Pump 260 bbl
No water
Comp.

Map No. *13* **KANSAS** Sec. *16* Twp. *25* R. *1E*

Well No. *1 Black.*

Starland Oil Company

Contractor

SECTION PLAT

.....Ft. from N. Line

330 Ft. from S. Line

990 Ft. from E. Line

.....Ft. from W. Line

	0		

FIRST REPORTS

Location.....

Rig up.....

Drilling and Remarks:

Rig


RECORD

Cased.....in.,ft.

Sand.....

Gas.....

Oil.....

Total Depth.....

PRODUCTION

1st 24 hrs. Nat.....

1st 24 hrs. after shot.....

Gas.....Cu. Ft.

Dry Hole.....

Abandoned.....

Date

MAY 1 1929
.....192.....

S. J. LEWIS Scout

Map No. KANSAS Sec. 16 Twp. 25 R. 1E

Well No. Black

Marland Oil Company

Contractor

SECTION PLAT

	0		

_____ Ft. from N. Line

330 Ft. from S. Line

990 Ft. from E. Line

_____ Ft. from W. Line

COMPLETED

Location _____

Rig up _____

Drilling and Remarks:

Chas 2977
Blow oil 2980-84
Pay 3009-1
Pump 200 ft

RECORD

Cased _____ in., _____ ft.

Sand _____

Gas _____

Oil _____

Total Depth 3012

PRODUCTION

1st 24 hrs. Nat. _____

1st 24 hrs. after shot _____

Gas _____ Cu. Ft.

Dry Hole _____

Abandoned _____

Date

JUL 10 1920

S. J. LEWIS Scout

Beagwick

E

Map No. KANSAS Sec. 16 Twp. 75 R. 1

Well No. 13 1 *Black*

Continental Oil Co. Company

Contractor

FIRST REPORTS

SECTION PLAT

.....Ft. from N. Line

330 Ft. from S. Line

990 Ft. from E. Line

.....Ft. from W. Line

	0		

OWDD

Location.....

Rig up *old 20 3012*

Drilling and Remarks:

Rigging up

RECORD

Cased.....in.,ft.

Sand.....

Gas.....

Oil.....

Total Depth.....

PRODUCTION

1st 24 hrs. Nat.....

1st 24 hrs. after shot.....

Gas.....Cu. Ft.

Dry Hole.....

Abandoned.....

Date

JUL 29 1931

CHAS. L. SHERWOOD

192.....Scout

13

Beagwick

E

Map No. KANSAS Sec. 16 Twp. 75 R. 1

Well No. 1 Black

Continental Oil Co Company

Contractor

COMPLETED

SECTION PLAT

Ft. from N. Line

330 Ft. from S. Line

990 Ft. from E. Line

Ft. from W. Line

Location

Rig up

Drilling and Remarks:

Pump 260 Bl
no water

RECORD

Cased 6 in., 3325 ft.

Sand holes 3334-37

Gas

Oil

Total Depth 3337

PRODUCTION

1st 24 hrs. Nat.

1st 24 hrs. after shot

Gas Cu. Ft.

Dry Hole

Abandoned

Date

SEP 30 1931

192

CHAS. L. SHERWOOD

Scout