


Section 13 Township 25 Range 1 E

Well No. # 2 Vandever "A"

Company Francis Raymond

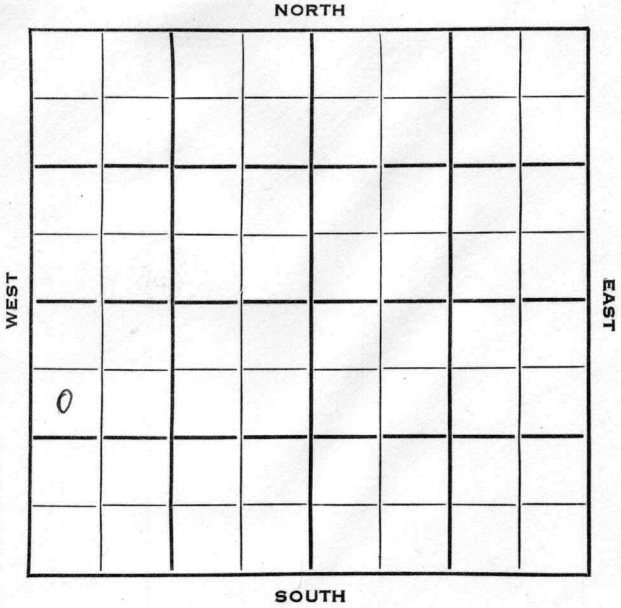

Sedgwick KANSAS

SEC.	TWP.	R.
13	25	1E ✓

WELL NO.

2 Vandever "A"

FARM

COMPANY

Francis Raymond

CONTRACTOR

Murfin Drlg.

Kuske Pool

990

Ft. from N. Line


Ft. from S. Line

Ft. from E. Line

330

Ft. from W. Line

SW NW SW

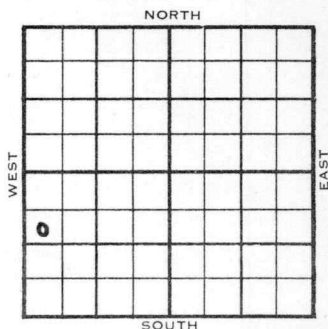

	ELEVATION	REPORT
1954	1148'	

4/21
6/23

Location

Spud 4-25-54 Oil well TD 3014
 8" @ 190 Lans. 2322 KC 2546'
 B KC 2733 Burgess sd 3006'
 TD 3007 5" @ 3007 DD 3014
 S/7 BOPH 6 hr.
 Comp. 173 BOPD

COMPLETED

County Sedgwick State KansasSec. 13 (Blk.) 25 (Sur.) 1E Map No.Operator Francis RaymondWell No. 2 Farm Vandever "A"Elev. Location SW NW SW

990 Ft. From N Line SW330 Ft. From W Line Quarter1st. Report APR 21 1954

Completion

Remarks

Murfin Drlg. - Contr.

Spudding Date

Drlg. Data Kuske PoolLocation

J. G. McGEHEE

County Sedgwick State Kansas
 Sec. 13 (Blk.) 2 (Sur.) 5 (Twp.) 5 1E Map No.
 Operator Francis Raymond
 Well No. 2 Farm Vandever "A"
 Elev. 1448 Location SW NW SW

990 Ft. From N Line SW
 330 Ft. From W Line Quarter

1st. Report

Completion JUN 23 1954

Remarks Kuske Pool

Murfin Drlg. - Contr.

Spudding Date 4-25-54

Drlg. Data Oil well TD 3014

8" @ 190 Lans. 2322 KC 2546

B KC 2733 Burgess sd. 3006 TD 3007

5" @ 3007 DD 3014 S/ 7 boph 6 hr.

Comp. 173 bopd