


Section 14 Township 25 Range 1E

Well No. #1 Beacher (Beecher)

Company Bennett & Gould

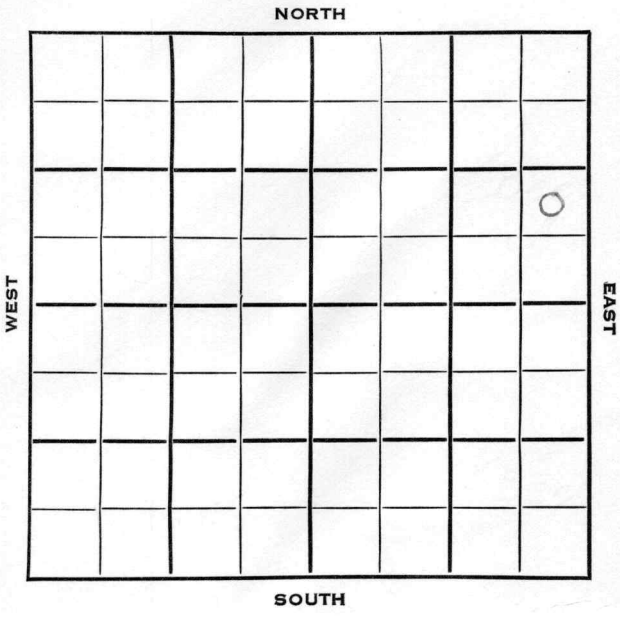

Sedgwick

KANSAS

SEC.

TWP.

R.

14

25

1E

WELL NO.

#1 Beacher

FARM

COMPANY

Bennett & Gould

CONTRACTOR

Salina Drlg.

Kuske Pool

NORTH

Ft. from N. Line

990

Ft. from S. Line

330

Ft. from E. Line

Ft. from W. Line

WEST

EAST

SOUTH

NE SE NE

ELEVATION

REPORT

1954

1454'

1/13

Burgess Sd. 3024',

TD 3028'

5" @ 3024'

DD 3030'

Dowell-frac. POP

4/7

Oil Well

TD 3030'

Burgess Sd 3024'

TD 3028'

5" @ 3024'

DD 3030' Dowell-frac sd-oil-frac

P/ 12 bopd 24 bw.

Comp 9 bopd 9 bw

COMPLETED

J. G. McGEHEE

County Sedgwick State Kansas

Sec. 14 (Blk. Twp.) 25 (Sur. Rge.) 1E Map No.

Operator Bennett & Gould

Well No. 1 Farm Beacher

Elev. 1454 Location NE SE NE

3

COMPLETE

990 Ft. From S Line NE

330 Ft. From E Line Quarter

1st. Report

Completion APR 7 1954

Remarks	Kuske Pool
---------	------------

Salina Drlg. - Contr.

Spudding Date _____

Drilg. Data Oil well TD 3030

Burgess sd. 3024 TD 3028 5" @ 3024

DD 3030 Dowell-frac sd-oil-frac

P/ 12 bopd 24 bw Comp. 9 bopd 9 bw

J. G. McGEHEE