


Sedgewick KANSAS

DX 78-1

Section 14 Township 25 Range 1E
Well No. 2 Difford-Leeper
Company Francis Raymond

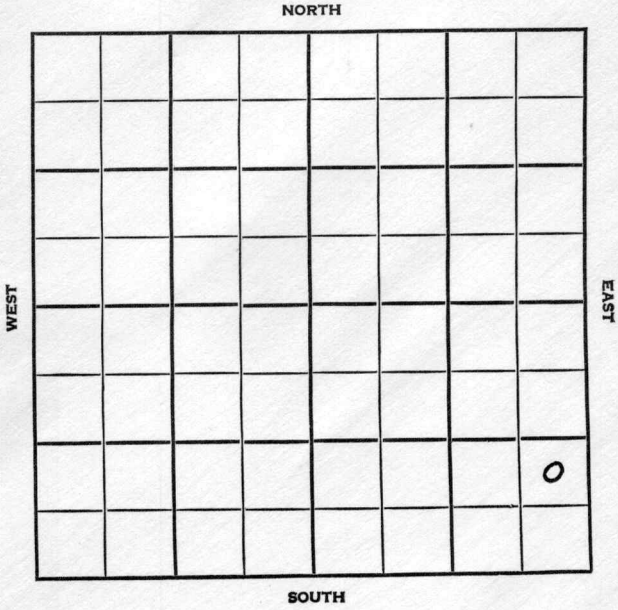

Sedgwick KANSAS


SEC.	TWP.	R.
14	25	1E

WELL NO. _____
 COMPANY 2 Difford-Leeper FARM

CONTRACTOR Francis Raymond

Murfin D rlg.
 Kuske Pool

_____ Ft. from N. Line
 990 _____ Ft. from S. Line
 330 _____ Ft. from E. Line
 _____ Ft. from W. Line

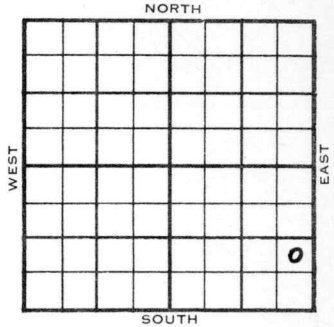

NE SE SE

	ELEVATION	REPORT
1954	1450' KB	

8/4

Spud 7-24-54
 8" @ 180'
 Lans 2328', KC 2553', B KC 2740',
 Burg. 3021'
 TD 3024'
 5" @ 3021'

9/15

Spud 7-24-54 - OilWell
 TD 3035'
 8" @ 180'
 Lans 2328', KC 2553', B KC
 2740', Burg. 3021'
 TD 3024'
 5" @ 3021'
 DD 3035 7 boph 50% wtr.
 Comp. 108 bopd 6% wtr.

COMPLETED

